Document 2005 18

Book 2005 Page 18 Type 06 43 Pages 1
Date 1/03/2005 Time 2:19 PM
Rec Amt $7.00

COMPUTER V
RECORDED V
COMPARED

MICHELLE "MICKI" UTSLER, COUNTY RECORDER
MADISON IOWA

RETURN TO : BOLDMAN LAND SURVEYING, P.C., BOX 66, WINTERSET, IA 50273 515-462-9242

UNITED STATES PUBLIC LAND SURVEY CORNER CERTIFICATE

OF


Land Survey Monuments situated in Section 33, Township 74, Range 27, of the Fifth Principal Meridian, Madison County, Iowa
Previously recorded in N/A In County Recorder's Office.
(book, page, document number, etc.)

(show reason for preparing this certificate, the evidence and detailed procedures used in establishing the corner positions and monumentation found or placed.)

Monument Description and Remarks: NE cor SE¼ NW¼ - location est. using "E-W fence and info. from prior survey Parcel "B." SE cor NW¼ - location est. using above info. and prior survey Actual corner not set due to large brush pile.

PLAN-VIEW

(Show a minimum of three reference ties to durable physical objects, relevant monuments and physical conditions that will enable recovery of the corner.)

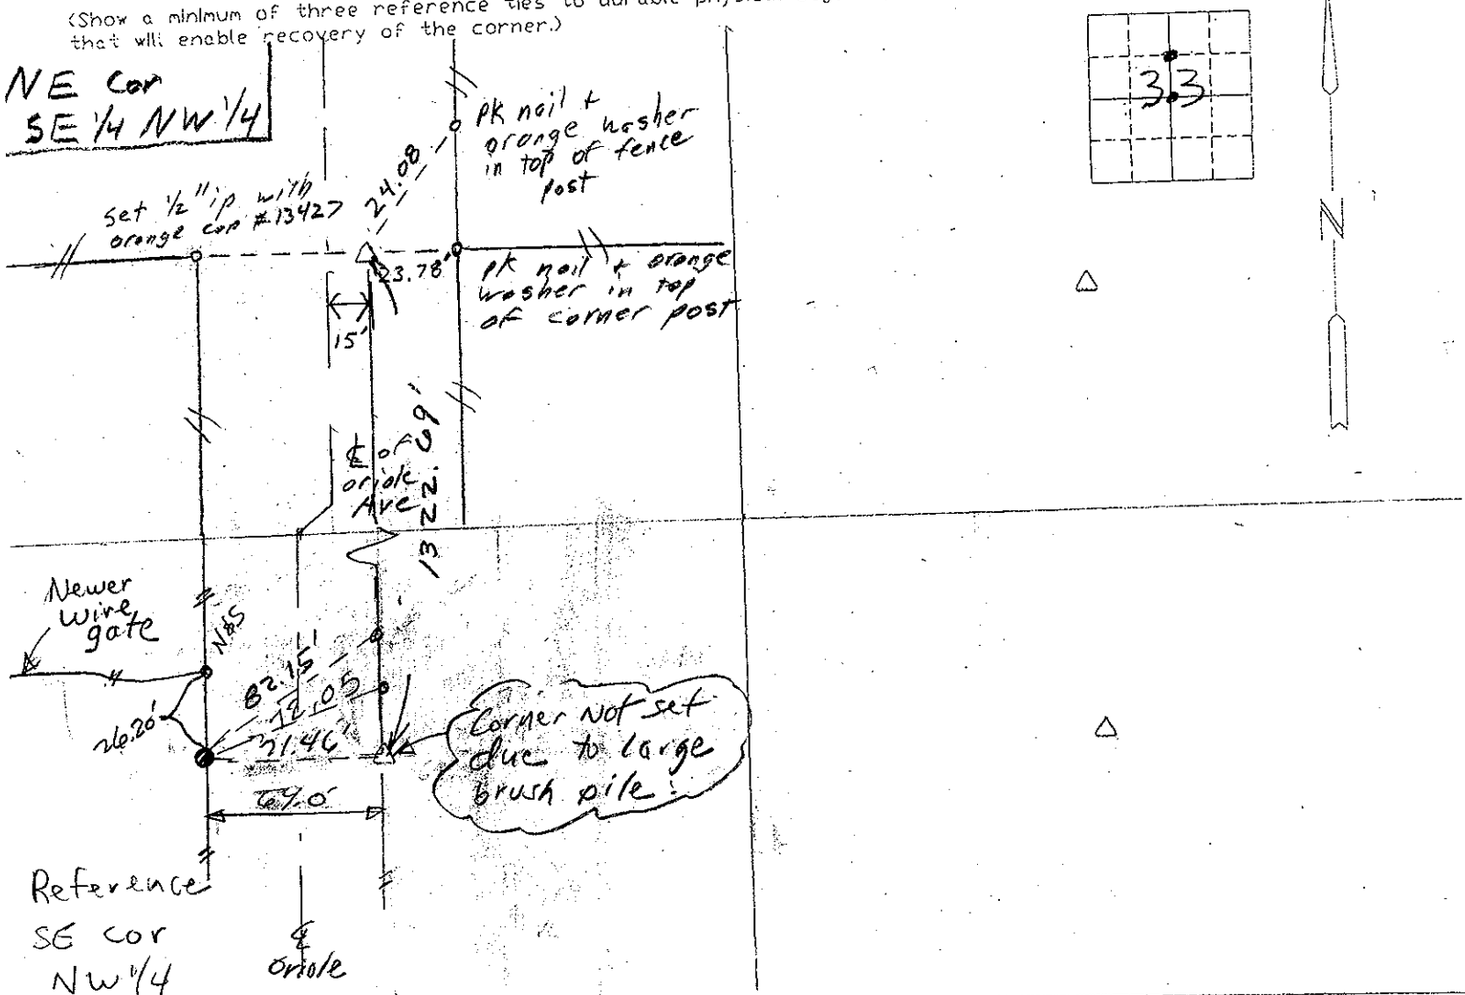

I hereby certify that the survey work was completed and this certificate was prepared by me or under my direct personal supervision and that I am a duly Licensed Land Surveyor under the laws of the State of Iowa

Signature: Craig S. Boldman

Date: 1/3/05 Reg. No. 13427

SEAL

LICENSED LAND SURVEYOR
CRAIG S. BOLDMAN
13427
IOWA

List Corners to be Indexed

Corners	Section	Twp	Range
NE Cor SE¼ NW¼	33	74	27
SE Cor NW¼	33	74	27

04084