Document 2005 372

Book 2005 Page 372 Type 06 43 Pages 1
Date 1/31/2005 Time 3:23 PM
Rec Amt $7.00

COMPUTER ✓
RECORDED ✓
COMPARED

MICHELLE "MICKI" UTSLER, COUNTY RECORDER
MADISON IOWA

VANCE & HOCHSTETLER, P.C., CONSULTING ENGINEERS, WINTERSET, IOWA (515) 462-3995
2004-215 CHARLES T. VANCE, 110 West Green St., Winterset, Iowa, 50273
JAMES M HOCHSTETLER, 110 West Green St., Winterset, Iowa 50273

UNITED STATES PUBLIC LAND SURVEY CORNER CERTIFICATE OF


Land Survey Monuments situated in Section 24, Township 77 N, Range 27W, of the Fifth Principal Meridian, MADISON County, Iowa.
Previously recorded in _____ (book, page, document number, etc.) in County Recorder's Office.

(Show reason for preparing this certificate, the evidence and detailed procedures used in establishing the corner positions and monumentation found or placed.)

Monument Description and Remarks: SW COR NW¼ SW¼ - Set yellow CIR #6808 at midpoint on line between found SW Corner & W ¼ Corner. SE COR NW¼ SW¼ - Set yellow CIR #6808 at mid point on line between found SE Corner NE¼ SW¼ and set SW Corner NW¼ SW¼

PLAN - VIEW

(Show a minimum of three reference ties to durable physical objects, relevant monuments and physical conditions that will enable recovery of the corner.)

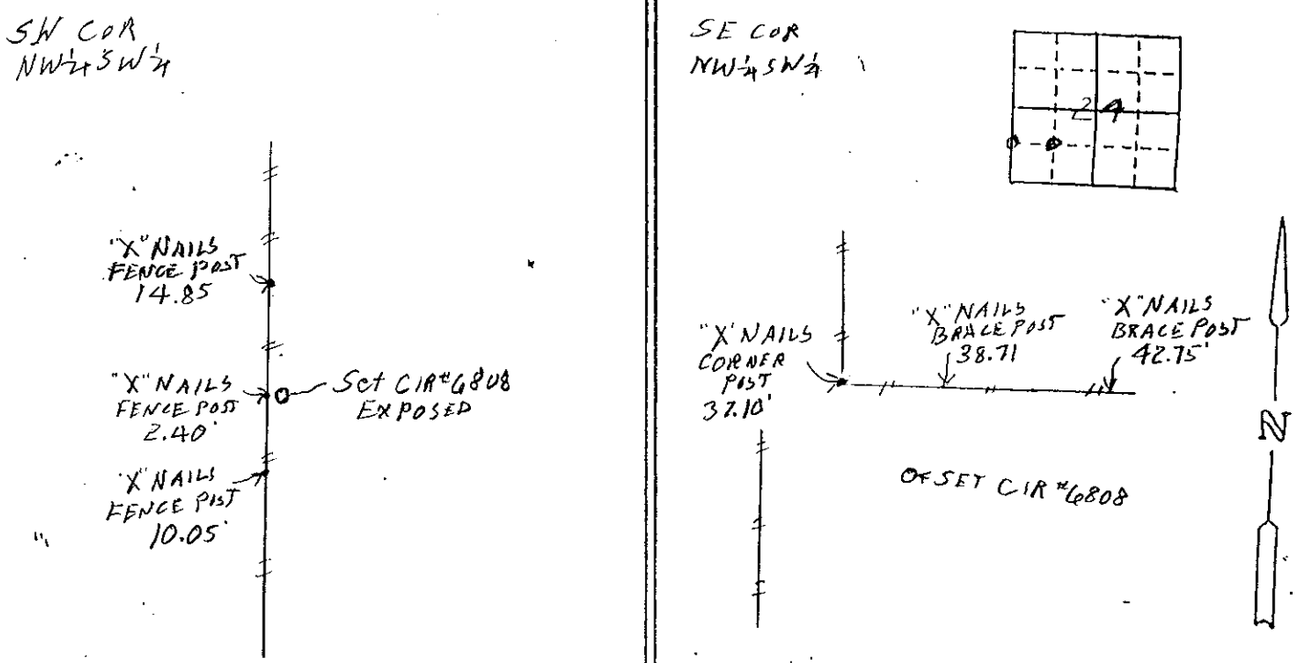

I hereby certify that this land surveying document was prepared and the related survey work was performed by me or under my direct personal supervision and that I am a duly licensed Land Surveyor under the laws of the State of Iowa.

J.M. HOCHSTETLER
License number 6808 Date 12/28/04.
My license renewal date is December 31, 2005
Pages or sheets covered by this seal: 1

LICENSED LAND SURVEYOR J. M. HOCHSTETLER 6808 IOWA

List Corners to be Indexed

Corners	Section	Twp	Range
SW COR NW¼ SW¼	24	77N	27W
SE COR NW¼ SW¼	24	77N	27W