

COMPUTER   
RECORDED   
COMPARED

MICHELLE "MICKI" UTSLER, COUNTY RECORDER  
MADISON IOWA

Prepared by Mark L. Lee, LEE Engineers & Surveyors, 8003 Douglas Avenue, Urbandale, Iowa 50322 Phone: 515-252-7457

### UNITED STATES PUBLIC LAND SURVEY CORNER CERTIFICATE OF



Land Survey Monuments situated in Section 27, Township 74 North, Range 27 West, of  
the Fifth Principal Meridian, MADISON County, Iowa.

Previously recorded in NONE in the County Recorder's Office.

Monument Description and Remarks:

NORTHEAST CORNER = SET 5/8" IRON PIPE WITH YELLOW CAP # 11582 ONLINE BETWEEN  
THE NORTH QUARTER CORNERS OF SECTIONS 26 AND 27; AND ONLINE WITH THE 5/8" IRON  
ROD AND THE SOUTHEAST CORNER OF THE N.E. 1/4, N.E. 1/4.

#### PLAN - VIEW

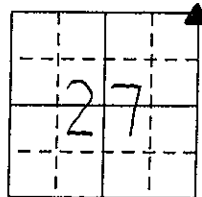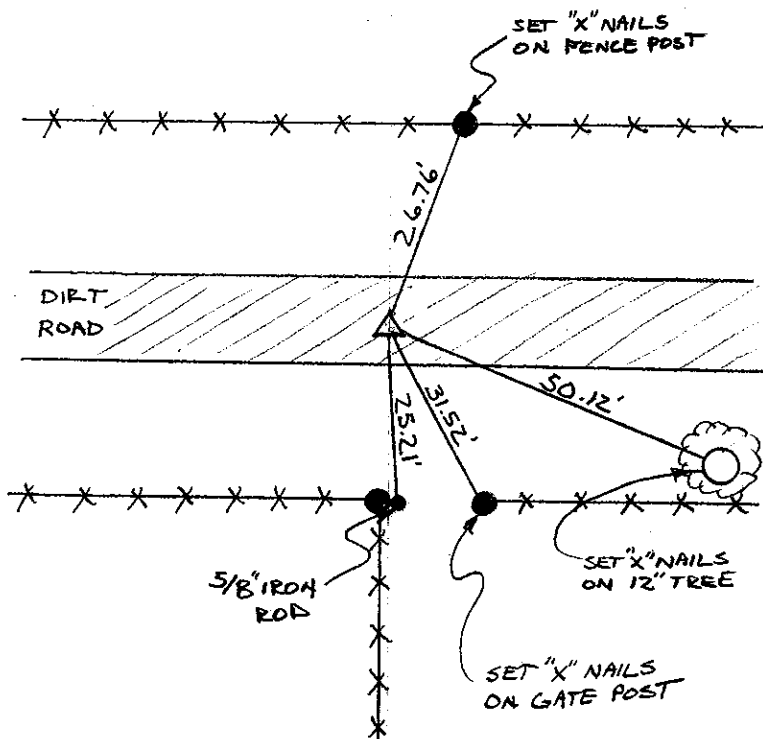

#### LEGEND

- ▲ FOUND SECTION CORNER MONUMENT
- FOUND MONUMENT
- I FOUND CHISELED "X" IN RIGHT-OF-WAY RAIL
- ⊗ FND "X" NAILS IN FENCE POST
- △ SECTION CORNER SET 5/8" I.P. W/YELLOW CAP #11582 (UNLESS NOTED)
- SET 1/2" I.R.
- × SET "X" NAILS IN FENCE POST
- I.P. IRON PIPE
- I.R. IRON ROD (REROD)
- (M) MEASURED DIMENSION
- (R) RECORDED DIMENSION
- SECTION LINE
- - - CENTERLINE
- × - × FENCE LINE
- ☼ SET "X" NAILS IN DECIDUOUS TREE

NORTHEAST CORNER  
SET 5/8" IRON PIPE WITH YELLOW CAP # 11582

I hereby certify that this land surveying document was prepared and the related survey work was performed by me or under my direct personal supervision and that I am a duly licensed Land Surveyor under the laws of the State of Iowa.

Signature: Mark L. Lee  
Mark L. Lee

Date: 1-12-05 Reg. No. 11582  
My license renewal date is Dec. 31, 2006.

Corners	Corners to be Indexed		
	Section	Twp.	Range
N.E. CORNER	27	74	27

