Document 2005 815

Book 2005 Page 815 Type 06 43 Pages 1
Date 2/25/2005 Time 10:49 AM
Rec Amt $7.00

COMPUTER ✓
RECORDED ✓
COMPARED

MICHELLE "MICKI" UTSLER, COUNTY RECORDER
MADISON IOWA

VANCE & HOCHSTETLER, P.C., CONSULTING ENGINEERS, WINTERSET, IOWA (515) 462-3995
04-240s CHARLES T. VANCE, 110 West Green St., Winterset, Iowa, 50273
JAMES M HOCHSTETLER, 110 West Green St., Winterset, Iowa 50273

UNITED STATES PUBLIC LAND SURVEY CORNER CERTIFICATE

Land Survey Monuments situated in Section OF 19, Township 76 NORTH, Range 29 WEST, of the Fifth Principal Meridian, MADISON County, Iowa.
Previously recorded in _____ (book, page, document number, etc.) in County Recorder's Office.

(Show reason for preparing this certificate, the evidence and detailed procedures used in establishing the corner positions and monumentation found or placed.)

Monument Description and Remarks:


SW cor NW.1/4 NE.1/4 - Set Capped Iron Rod (1/2" rebar, exposed) #6808 at existing 3-way fence corner

SE cor NW.1/4 NE.1/4 - Set C.I.R. #6808 (1/2" rebar, 1-2" deep) at the intersection of a line between the NE cor. NW.1/4 NE.1/4 and the SE cor. SW.1/4 NE.1/4 and an existing E-W Fenceline to the West


PLAN - VIEW


(Show a minimum of three reference ties to durable physical objects, relevant monuments and physical conditions that will enable recovery of the corner.)


SW CORNER
NW.1/4 NE.1/4
SEC. 19-76-29
Set C.I.R. #6808

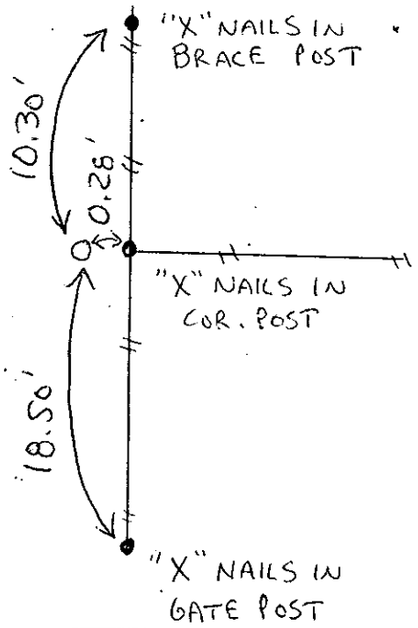

SE CORNER
NW.1/4 NE.1/4
SEC. 19-76-29
Set C.I.R. #6808

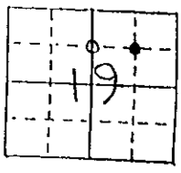

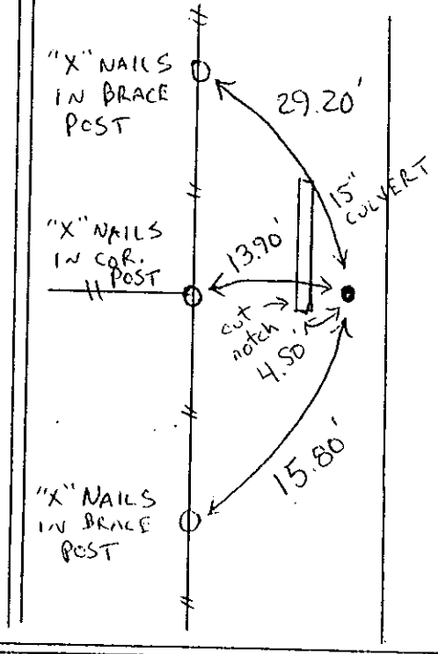

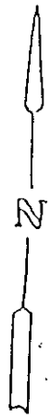

LICENSED LAND SURVEYOR
J. M. HOCHSTETLER #6808
IOWA

I hereby certify that this land surveying document was prepared and the related survey work was performed by me or under my direct personal supervision and that I am a duly licensed Land Surveyor under the laws of the State of Iowa.

J.M. Hochstetler

J.M. HOCHSTETLER
License number 6808 Date 2/18/05
My license renewal date is December 31, 2005
Pages or sheets covered by this seal: 1

List Corners to be Indexed

Corners	Section	Twp	Range
SW cor NW.1/4 NE.1/4	19	76N	29W
SE cor NW 1/4 NE.1/4	19	76N	29W