COMPUTER ✓
RECORDED ✓
COMPARED

Document 2005 1275

Book 2005 Page 1275 Type 06 43 Pages 1
Date 3/28/2005 Time 10:56 AM
Rec Amt $7.00

MICHELLE "MICKI" UTSLER, COUNTY RECORDER
MADISON IOWA

RETURN TO: BOLDMAN LAND SURVEYING, P.C., BOX 66, WINTERSET, IA 50273 515-462-9242

UNITED STATES PUBLIC LAND SURVEY CORNER CERTIFICATE OF


Land Survey Monuments situated in Section 22, Township 77, Range 28, of the Fifth Principal Meridian, Madison County, Iowa
Previously recorded in None found (book, page, document number, etc.) In County Recorder's Office.

(show reason for preparing this certificate, the evidence and detailed procedures used in establishing the corner positions and monumentation found or placed.)

Monument Description and Remarks: Set 1/2 way betn NW & W 1/4 cors

PLAN-VIEW

(Show a minimum of three reference ties to durable physical objects, relevant monuments and physical conditions that will enable recovery of the corner.)

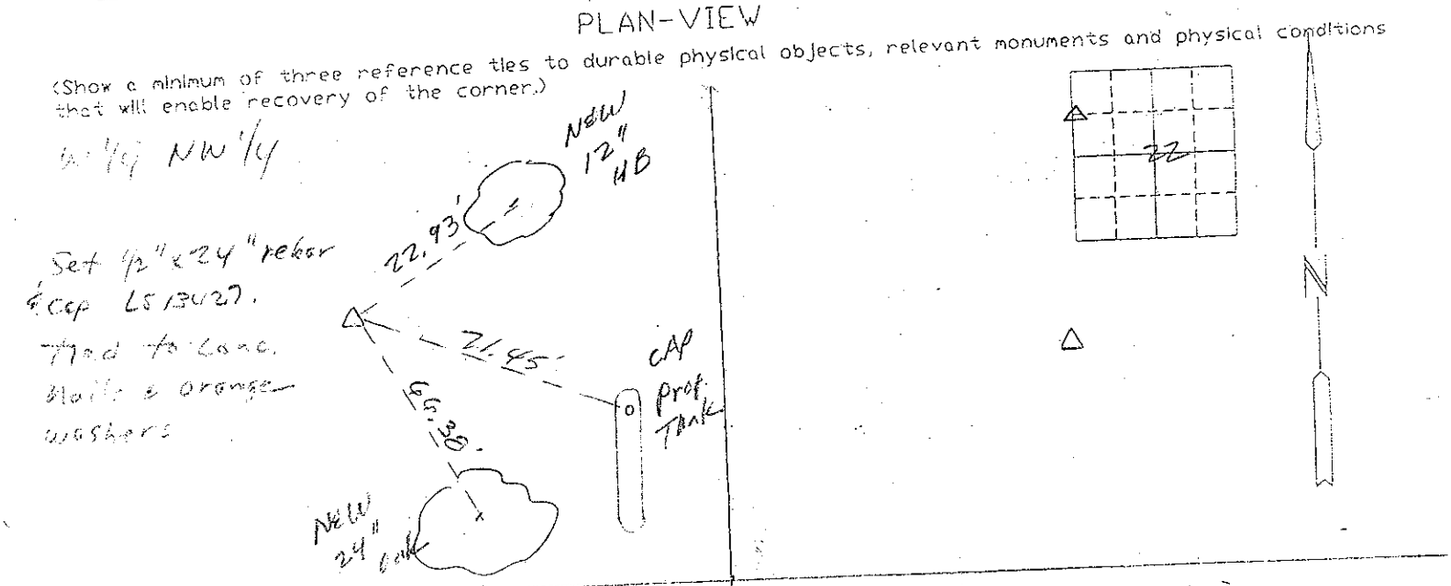

I hereby certify that the survey work was completed and this certificate was prepared by me or under my direct personal supervision and that I am a duly Licensed Land Surveyor under the laws of the State of Iowa

Signature: Craig S. Boldman
Craig S. Boldman

Date: 3/27/05 Reg. No. 13427

SEAL

LICENSED LAND SURVEYOR
CRAIG S. BOLDMAN
13427
12/31/06
IOWA

List Corners to be indexed

Corners	Section	Twp	Range
W 1/4 NW 1/4	22	77	28
E 1/4 NE 1/4	21	77	28

Job # 05004