


MICHELLE "MICKI" UTSLER, COUNTY RECORDER
MADISON IOWA

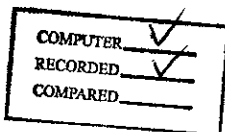

ASSOCIATED ENGINEERING COMPANY OF IOWA, 2917 MARTIN LUTHER KING JR. PARKWAY, DES MOINES, IOWA, (515) 255-3156

UNITED STATES PUBLIC LAND SURVEY CORNER CERTIFICATE OF

Land survey monuments situated in Section 1, Township 76, Range 27
of the Fifth Principal Meridian, MADISON County, Iowa. Previously recorded
in N/A in County Recorder's Office.

(Show reason for preparing this certificate, the evidence and detailed procedures used in establishing the corner positions & monumentation found or placed.)

MONUMENT DESCRIPTION AND REMARKS:

NE COR SW1/4 SW1/4, FOUND POINTED ROCK, SET 1/2" REROD W/ YLW CAP #15982
ON SW SIDE 0.2' BELOW TOP OF ROCK
SE COR SW1/4 SW1/4, SET 1/2" REROD W/ YLW CAP #15982, ON LINE FROM
SE COR OF SEC 1 AND SW COR SEC 1. AT 1/4 DISTANCE BETWEEN

PLAN - VIEW

(Show a minimum of three reference ties to durable physical objects, relevant monuments and physical conditions that will enable recovery of the corner.)

POINTED ROCK
1/2" REROD YLW CAP #15982
SW SIDE 0.2' BLW TOP

60 PENNY
8" ELM

X NAILS IN
COR POST


NE COR SW1/4 SW1/4
SEC 1-76-27

X NAILS IN
FENCE POST

X NAILS IN
BRACE POST

X NAILS IN
FENCE POST

SE COR SW1/4 SW1/4
SEC 1-76-27

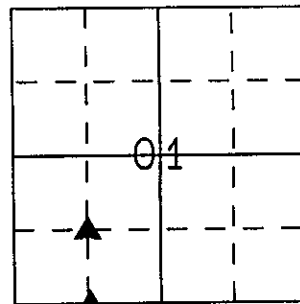

(ALL DISTANCE ARE MEASURED HORIZONTAL UNLESS NOTED)

I hereby certify that this land surveying document was prepared and the related survey work was performed by me or under my direct personal supervision and that I am a duly licensed Land Surveyor, under the laws of the State of Iowa.

Signed

Date

VINCENT E PIAGENTINI, L.S., Iowa Reg. No 15982
MY LICENSE RENEWAL DATE IS - DECEMBER 31, 2005

PAGES OR SHEETS COVERED BY THIS SEAL: 1 OF 1



Corners to be Indexed

Corner	Section	Twp.	Range
NE COR SW1/4 SW1/4	1	76	27
SE COR SW1/4 SW1/4	1	76	27
NE COR NW1/4 NW1/4	12	76	27