001408

FILED NO. _____

BOOK 2001 PAGE 1408

2001 APR 10 AM 11:06

MICKI UTSLER
RECORDER
MADISON COUNTY, IOWA

REC $ 5.00
AUD $ _____
R.M.F. $ 1.00

COMPUTER ✓
RECORDED ✓
COMPARED _____

✓

VANCE & HOCHSTETLER, P.C., CONSULTING ENGINEERS, WINTERSET, IOWA (515) 462-3995
CHARLES T. VANCE, 110 West Green St., Winterset, Iowa, 50273
JAMES M HOCHSTETLER, 110 West Green St., Winterset, Iowa 50273

01-265

# UNITED STATES PUBLIC LAND SURVEY CORNER CERTIFICATE

OF

Land Survey Monuments situated in Section 5, Township 74 N, Range 28 W, of the Fifth Principal Meridian, MADISON County, Iowa.

Previously recorded in _____ in County Recorder's Office.
(book, page, document number, etc.)

(Show reason for preparing this certificate, the evidence and detailed procedures used in establishing the the corner positions and monumentation found or placed.)

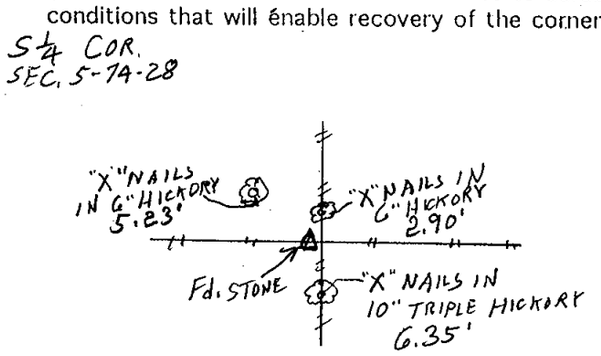
Monument Description and Remarks: S¼ Cor. - Found Stone at 4 way property line fence intersection. Also shown on a plat of Survey completed in 1985.

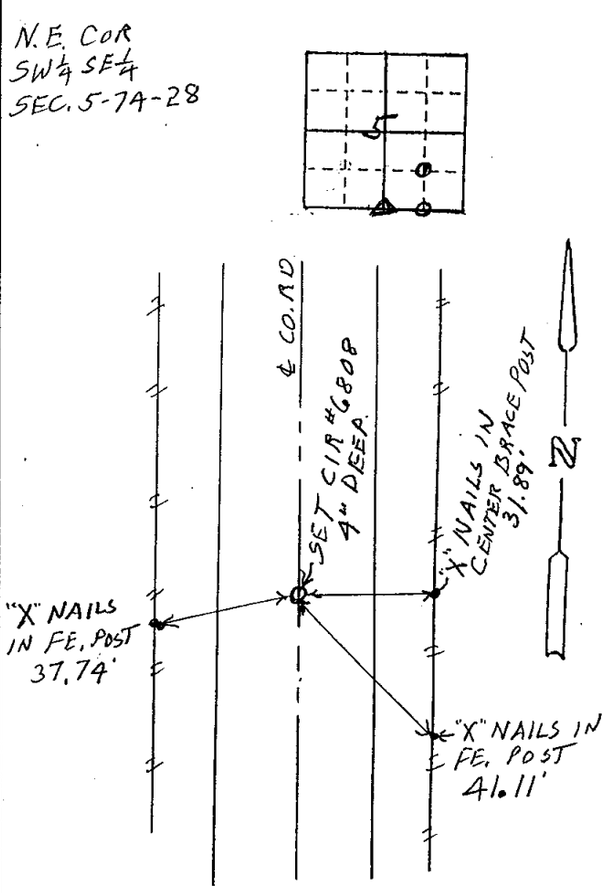
SE COR SW¼ SE¼ - Found CIR #6808 Set in 1985 for Survey at mid point between Stones found at S¼ Corner and S.E. Corner which also matched ℄ of County Road: Yellow C.I.R. #6808 3" Deep

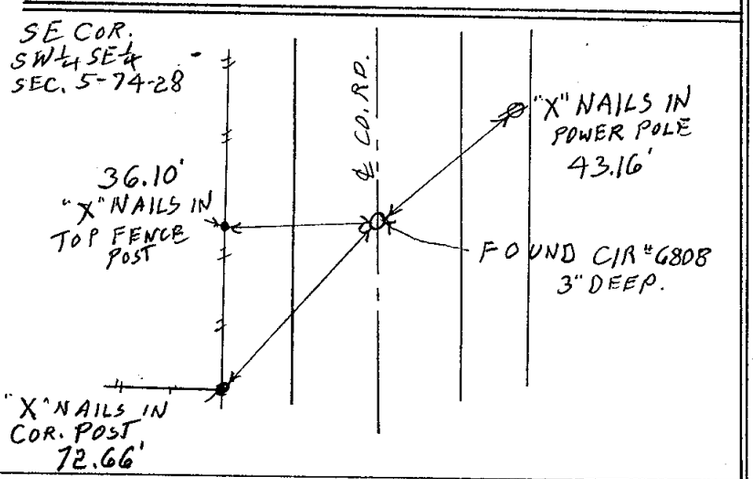
N.E. COR. SW¼ SE¼ - Set Yellow CIR #6808 4" Deep on ℄ County Road R.O.W. at mid point between found S.E. COR SW¼ SE¼ and ℄ County Road R.O.W. to West at N.E. COR NW¼ SE¼.

## PLAN - VIEW

(Show a minimum of three reference ties to durable physical objects, relevant monuments and physical conditions that will enable recovery of the corner.)




LICENSED LAND SURVEYOR
J. M. HOCHSTETLER
6808
IOWA

I hereby certify that this land surveying document was prepared and the related survey work was performed by me or under my direct personal supervision and that I am a duly licensed Land Surveyor under the laws of the State of Iowa.

J.M. HOCHSTETLER

License number 6808 Date 3/23/01

My license renewal date is December 31, 2001

Pages or sheets covered by this seal: 1

List Corners to be Indexed

| Corners | Section | Twp | Range |
|---|---|---|---|
| S¼ COR. | 5 | 74N | 28W |
| SE. COR. SW¼ SE¼ | 5 | 74N | 28W |
| N.E. COR. SW¼ SE¼ | 5 | 74N | 28W |