FILED NO. 001949

BOOK 2001 PAGE 1949

2001 MAY 14 PM 2:29

NICKI UTSLER
RECORDER
MADISON COUNTY, IOWA

REC $ 5.00
AUD $
R.M.F. $ 1.00

COMPUTER ✓
RECORDED ✓
COMPARED

VANCE & HOCHSTETLER, P.C., CONSULTING ENGINEERS, WINTERSET, IOWA (515) 462-3995
CHARLES T. VANCE, 110 West Green St., Winterset, Iowa, 50273
JAMES M HOCHSTETLER, 110 West Green St., Winterset, Iowa 50273

UNITED STATES PUBLIC LAND SURVEY CORNER CERTIFICATE

OF


Land Survey Monuments situated in Section 2, Township 74N, Range 27W, of the Fifth Principal Meridian, MADISON County, Iowa.
Previously recorded in _____ in County Recorder's Office.
(book, page, document number, etc.)


(Show reason for preparing this certificate, the evidence and detailed procedures used in establishing the the corner positions and monumentation found or placed.)

Monument Description and Remarks: S.W COR - Set Yellow C.I.R. based on recorded measurements to ℄ old HWY #307 and old Ia. D.O.T. Ties to Corner. Ia. DOT Set Concrete Monument in 1960 but we could not find it.
W¼ Cor. - Found Yellow C.I.R. #Unreadable at point where old Ia. DOT Ties would indicate they set a Concrete monument, Could not find Concrete Monument.

PLAN - VIEW

(Show a minimum of three reference ties to durable physical objects, relevant monuments and physical conditions that will enable recovery of the corner.)

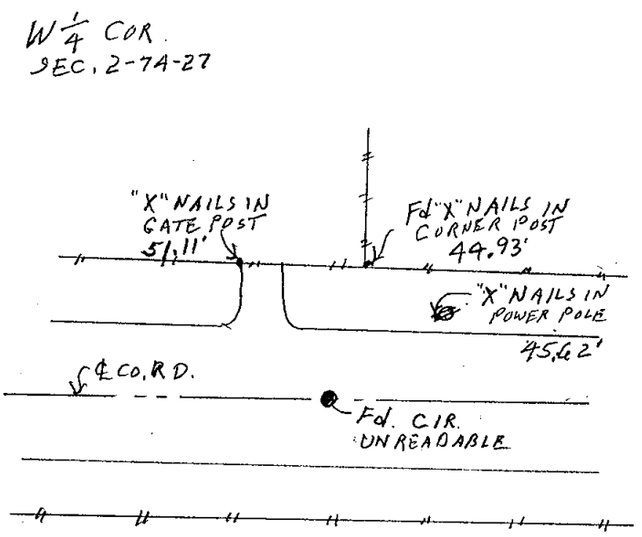

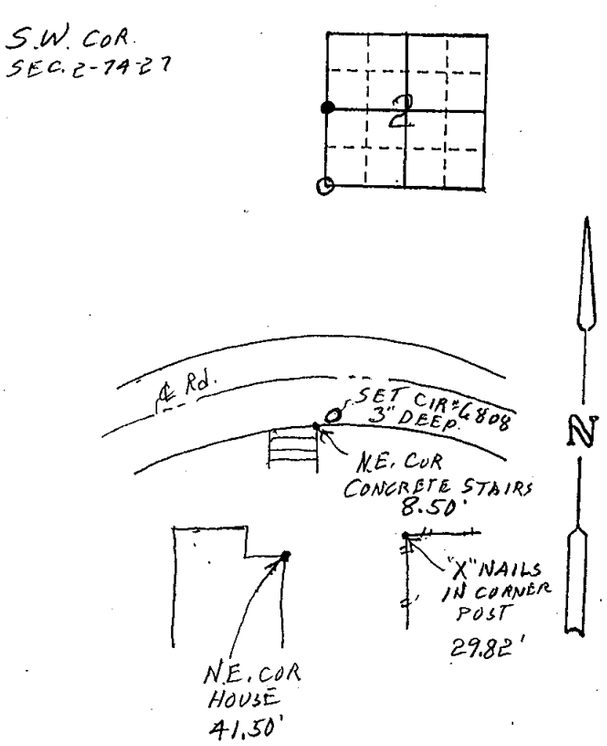

I hereby certify that this land surveying document was prepared and the related survey work was performed by me or under my direct personal supervision and that I am a duly licensed Land Surveyor under the laws of the State of Iowa.

J. M. Hochstetler

J.M. HOCHSTETLER
License number 6808 Date 4/26/01.
My license renewal date is December 31, 2001
Pages or sheets covered by this seal: 1

LICENSED LAND SURVEYOR
J. M. HOCHSTETLER
6808
IOWA

List Corners to be Indexed

Corners	Section	Twp	Range
S.W. Cor.	2	74N.	27W
W ¼ Cor	2	74N	27W