002142

FILED NO.

BOOK 2001 PAGE 2142

2001 MAY 25 AM 11:09

MICKI UTSLER
RECORDER
MADISON COUNTY, IOWA

REC $ 5.00
AUD $
R.M.F. $ 1.00

COMPUTER ✓
RECORDED ✓
COMPARED

VANCE & HOCHSTETLER, P.C. CONSULTING ENGINEERS, WINTERSET, IOWA (515) 462-3995
CHARLES T. VANCE, 110 WEST GREEN ST., WINTERSET, IOWA 50273
JAMES M HOCHSTETLER, 110 WEST GREEN ST., WINTERSET, IOWA 50273

A PLAT OF SURVEY FOR GARY AND MARY ANN ORR OF LOTS 5, 6, & 7, BLOCK 8, OF PITZER & KNIGHTS ADDITION TO THE CITY OF WINTERSET, MADISON COUNTY, IOWA

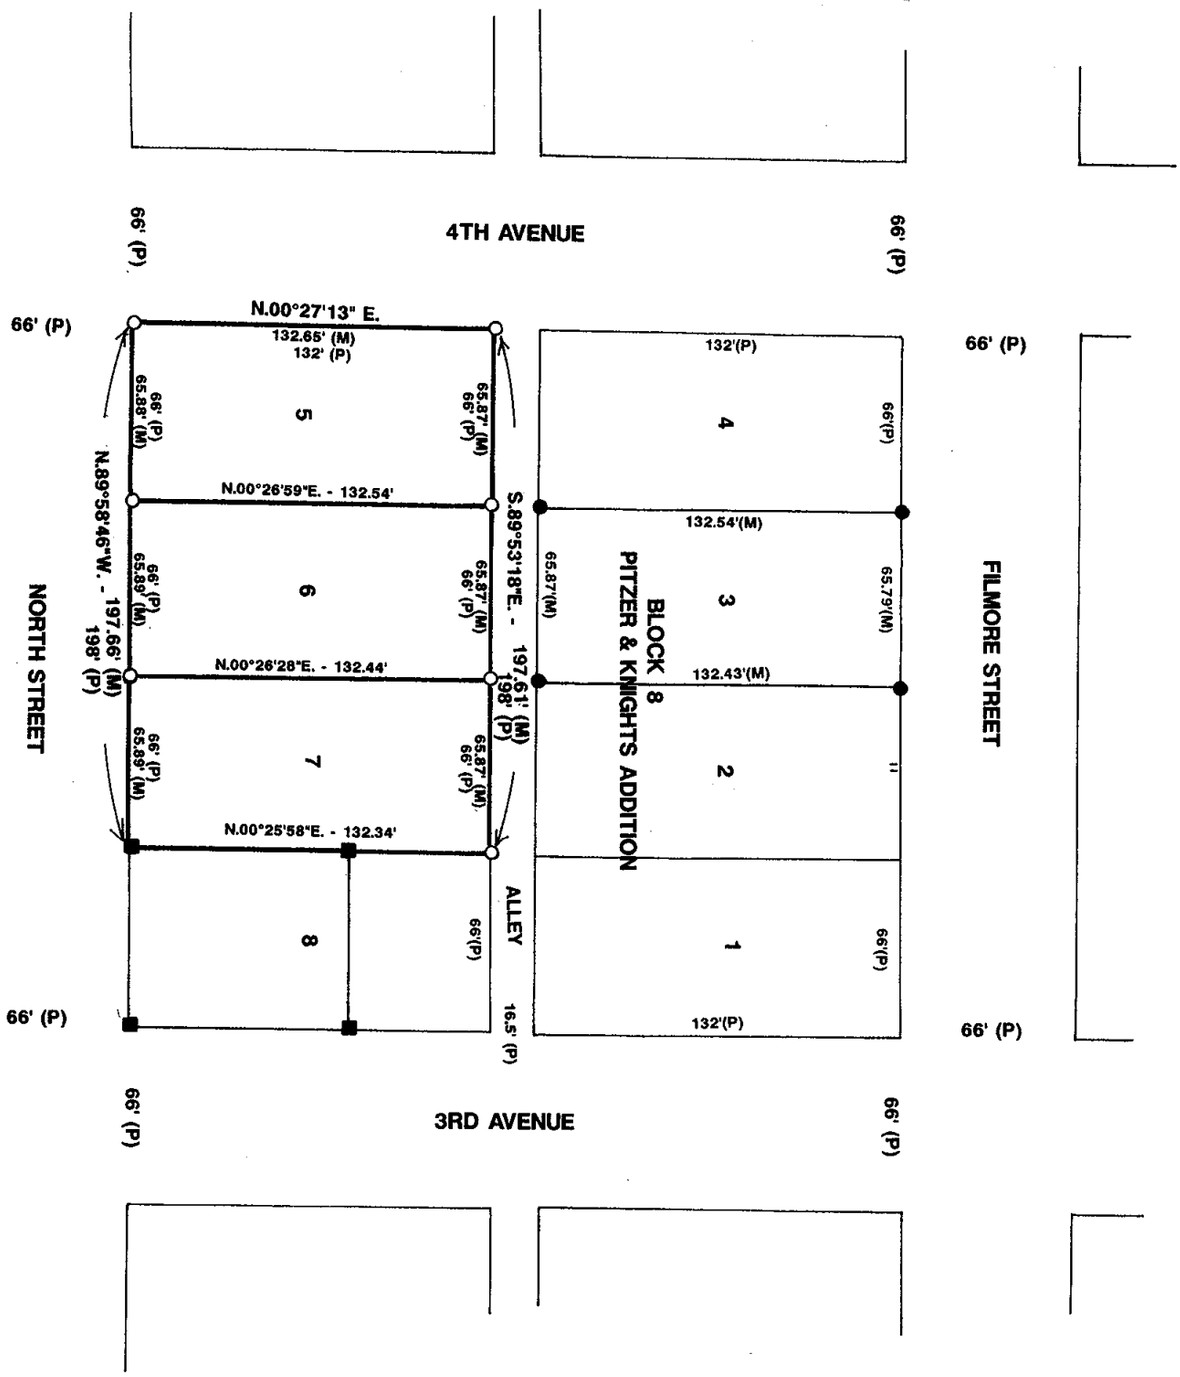

SCALE 1" = 100'
DATE OF SURVEY = 5/15/01

0 100' 200'

○ CAPPED IRON ROD (CIR) #6808 SET
● CIR #6808 FOUND
■ CIR #5041 FOUND
(M) MEASURED DISTANCE
(P) PLATTED DISTANCE

LICENSED LAND SURVEYOR
J. M. HOCHSTETLER
6808
IOWA

I hereby certify that this land surveying document was prepared and the related survey work was performed by me or under my direct personal supervision and that I am a duly licensed Land Surveyor under the laws of the State of Iowa.

J.M. HOCHSTETLER
License number 6808 Date 5/14/01
My license renewal date is December 31 2001
Pages or sheets covered by this seal: 1