FILED NO. 003277
BOOK 2001 PAGE 3277
2001 JUL 27 AM 10: 06
MICKI UTSLER
RECORDER
MADISON COUNTY, IOWA

REC $ 5.00
AUD $
R.M.F. $ 1.00

COMPUTER ✓
RECORDED ✓
COMPARED

VANCE & HOCHSTETLER, P.C., CONSULTING ENGINEERS, WINTERSET, IOWA (515) 462-3995
CHARLES T. VANCE, 110 West Green St., Winterset, Iowa, 50273
JAMES M HOCHSTETLER, 110 West Green St., Winterset, Iowa 50273

01-1335

UNITED STATES PUBLIC LAND SURVEY CORNER CERTIFICATE

OF

Land Survey Monuments situated in Section 14, Township 74 North, Range 26 West, of the Fifth Principal Meridian, MADISON County, Iowa.
Previously recorded in _____ in County Recorder's Office.
(book, page, document number, etc.)

(Show reason for preparing this certificate, the evidence and detailed procedures used in establishing the the corner positions and monumentation found or placed.)

Monument Description and Remarks:


E. 1/4 cor. - Set Capped Iron Rod #6808 (1/2" rebar, exposed) at existing 3-way Fence corner (North, East and Southwest)

SW cor SE. 1/4 NE. 1/4 - Set C.I.R. #6808 (1/2" rebar, exposed) at midpoint of line between Center and East 1/4 cor.


PLAN - VIEW


(Show a minimum of three reference ties to durable physical objects, relevant monuments and physical conditions that will enable recovery of the corner.)


EAST 1/4 COR.
SEC. 14-74-26
Set C.I.R. #6808

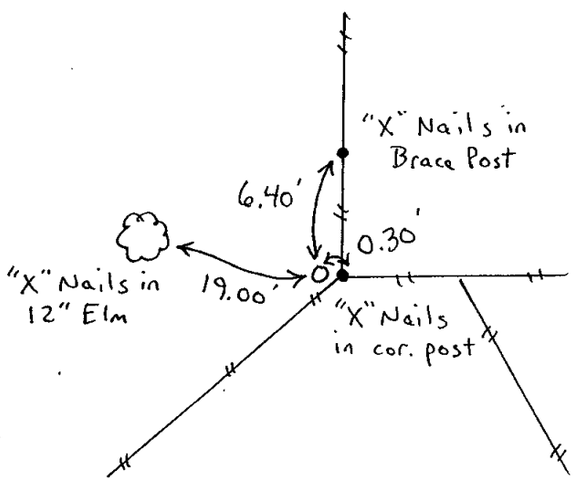

SW CORNER
SE. 1/4 NE. 1/4
SEC. 14-74-26
Set C.I.R. #6808

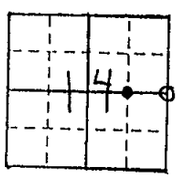

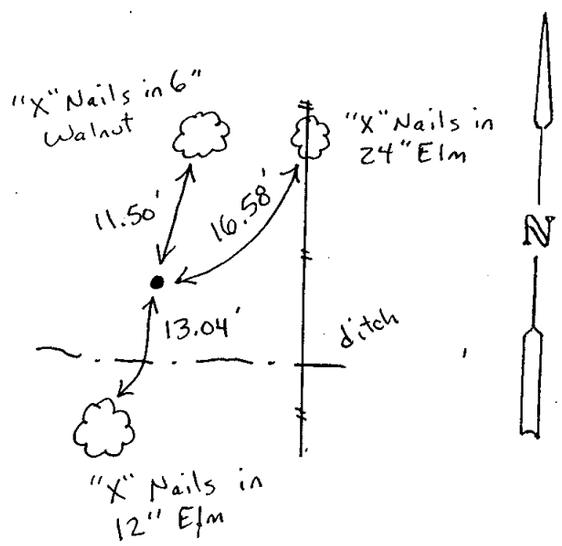

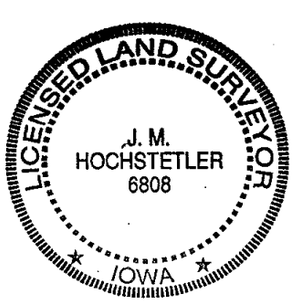

I hereby certify that this land surveying document was prepared and the related survey work was performed by me or under my direct personal supervision and that I am a duly licensed Land Surveyor under the laws of the State of Iowa.

J.M. Hochstetler

J.M. HOCHSTETLER
License number 6808 Date 7/23/01.
My license renewal date is December 31, 2001
Pages or sheets covered by this seal: 1

List Corners to be Indexed

Corners	Section	Twp	Range
E. 1/4 cor.	14	74N	26W
SW cor SE. 1/4 NE. 1/4	14	74N	26W