REC $5.00
AUD $ ____
R.M.F. $1.00

FILED NO. 002853

BOOK 2001 PAGE 2853

COMPUTER ✓
RECORDED ✓ 01 JUL -9 PM 3:53
COMPARED ____

MICKI UTSLER
RECORDER
MADISON COUNTY, IOWA

VANCE & HOCHSTETLER, P.C., CONSULTING ENGINEERS, WINTERSET, IOWA (515) 462-3995
CHARLES T. VANCE, 110 West Green St., Winterset, Iowa, 50273
JAMES M HOCHSTETLER, 110 West Green St., Winterset, Iowa 50273

UNITED STATES PUBLIC LAND SURVEY CORNER CERTIFICATE

OF

Land Survey Monuments situated in Section 18, Township 74 North, Range 27 West, of the Fifth Principal Meridian, MADISON County, Iowa.
Previously recorded in _____ in County Recorder's Office.
(book, page, document number, etc.)

(Show reason for preparing this certificate, the evidence and detailed procedures used in establishing the the corner positions and monumentation found or placed.)


Monument Description and Remarks:

NW cor - Fd. Capped Iron Rod #5041 (½" rebar, 4" deep) set in 1989

SW cor NW Fr. ¼ NW. ¼ - Fd. C.I.R. #5041 (½" rebar, 4" deep) set in 1989.

PLAN - VIEW

(Show a minimum of three reference ties to durable physical objects, relevant monuments and physical conditions that will enable recovery of the corner.)

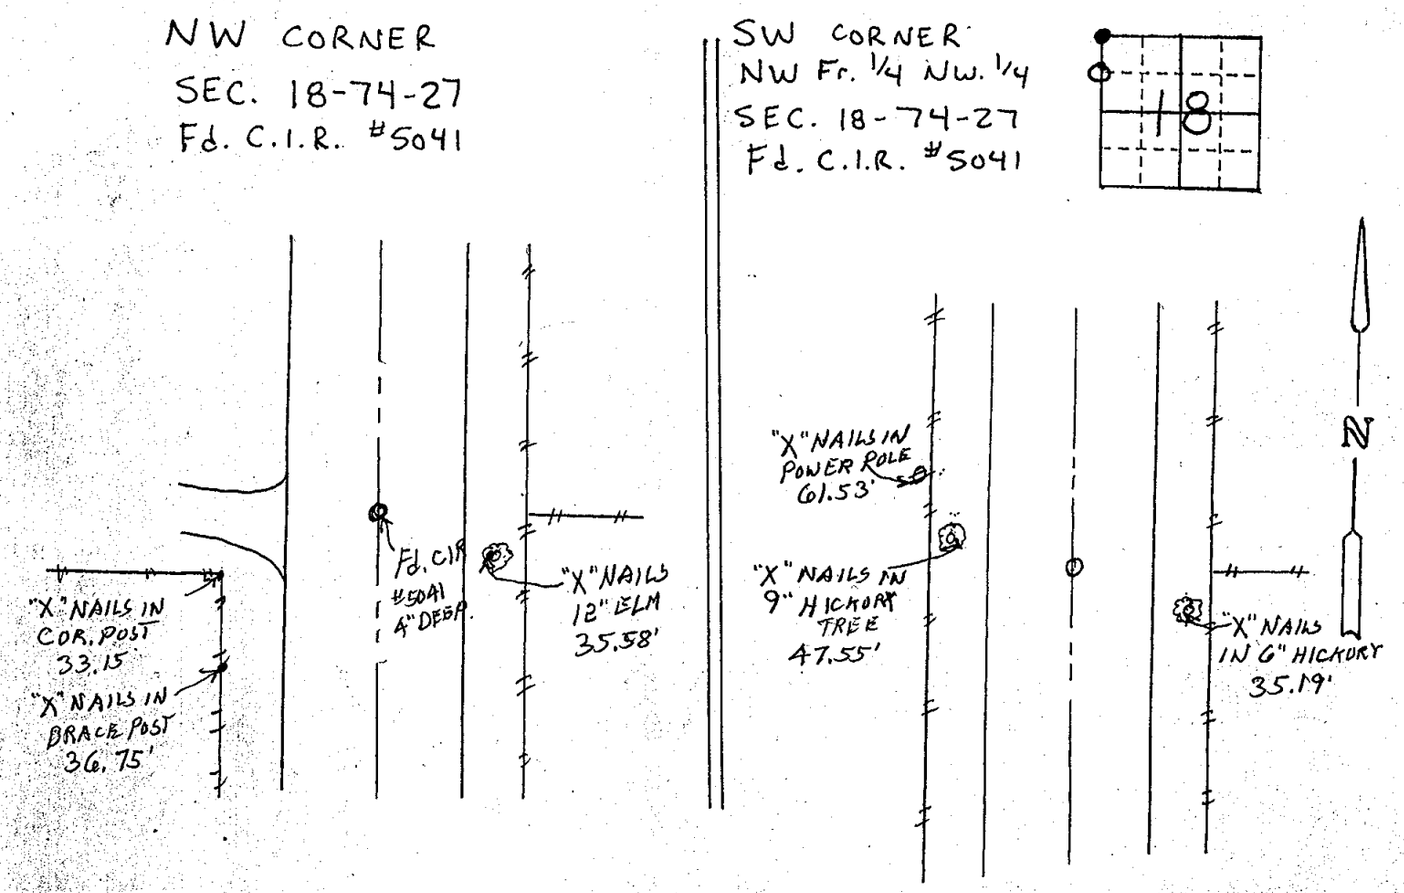

LICENSED LAND SURVEYOR
J. M. HOCHSTETLER
6808
IOWA

I hereby certify that this land surveying document was prepared and the related survey work was performed by me or under my direct personal supervision and that I am a duly licensed Land Surveyor under the laws of the State of Iowa.

J. M. HOCHSTETLER
License number 6808 Date 7/2/01
My license renewal date is December 31, 2001
Pages or sheets covered by this seal: 1

List Corners to be Indexed

Corners	Section	Twp	Range
NW cor	18	74N	27W
SW cor NW Fr. ¼ NW. ¼	18	74N	27W