REC $ 5.00
AUD $
R.M.F. $ 1.00

FILED NO. 002855
BOOK 2001 PAGE 2855

COMPUTER ✓ 01 JUL -9 PM 3:58
RECORDED ✓
COMPARED

MICKI UTSLER
RECORDER
MADISON COUNTY, IOWA

VANCE & HOCHSTETLER, P.C., CONSULTING ENGINEERS, WINTERSET, IOWA (515) 462-3995
CHARLES T. VANCE, 110 West Green St., Winterset, Iowa, 50273
JAMES M HOCHSTETLER, 110 West Green St., Winterset, Iowa 50273

UNITED STATES PUBLIC LAND SURVEY CORNER CERTIFICATE

OF

Land Survey Monuments situated in Section 4, Township 75N, Range 27W, of the Fifth Principal Meridian, MADISON County, Iowa.
Previously recorded in _____ in County Recorder's Office.
(book, page, document number, etc.)


(Show reason for preparing this certificate, the evidence and detailed procedures used in establishing the the corner positions and monumentation found or placed.)


Monument Description and Remarks: NW Cor. SW¼ NW¼ - Set yellow CIR #6808 exposed on line between found NW Cor and W¼ Cor at prorated distance comparing original survey distance to current measured distance allowing for fractional NW¼ NW¼.


PLAN - VIEW


(Show a minimum of three reference ties to durable physical objects, relevant monuments and physical conditions that will enable recovery of the corner.)

NW COR-SW¼ NW¼

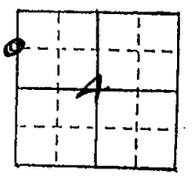

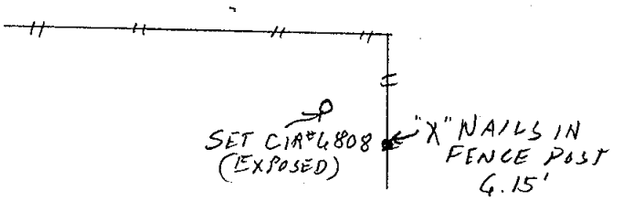

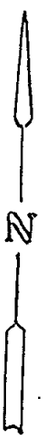

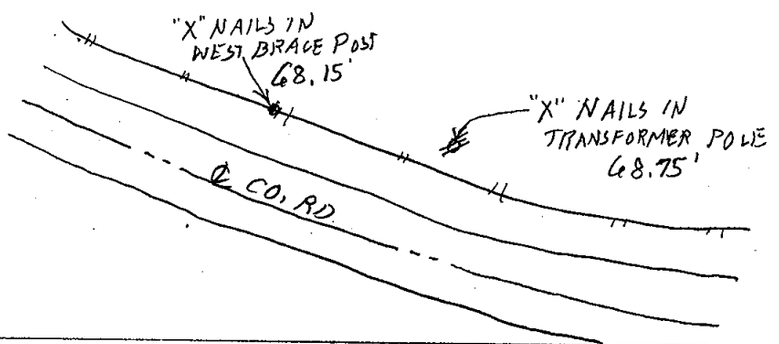

LICENSED LAND SURVEYOR
J. M.
HOCHSTETLER
6808
IOWA

I hereby certify that this land surveying document was prepared and the related survey work was performed by me or under my direct personal supervision and that I am a duly licensed Land Surveyor under the laws of the State of Iowa.

J.M. Hochstetler

J.M. HOCHSTETLER
License number 6808 Date 7/9/01.
My license renewal date is December 31, 2001
Pages or sheets covered by this seal: 1

List Corners to be Indexed

Corners	Section	Twp	Range
NW cor SW¼ NW¼	4	75N	27W