REC $ 5.00 FILED NO. 002856
AUD $
R.M.F. $ 1.00 BOOK 2001 PAGE 2856
COMPUTER ✓ 01 JUL -9 PM 3:59
RECORDED ✓
COMPARED
MICKI UTSLER
RECORDER
MADISON COUNTY, IOWA

VANCE & HOCHSTETLER, P.C., CONSULTING ENGINEERS, WINTERSET, IOWA (515) 462-3995
CHARLES T. VANCE, 110 West Green St., Winterset, Iowa, 50273
JAMES M HOCHSTETLER, 110 West Green St., Winterset, Iowa 50273

UNITED STATES PUBLIC LAND SURVEY CORNER CERTIFICATE

OF

Land Survey Monuments situated in Section 5, Township 75N, Range 27W, of the Fifth Principal Meridian, MADISON County, Iowa.
Previously recorded in _____ in County Recorder's Office.
(book, page, document number, etc.)

(Show reason for preparing this certificate, the evidence and detailed procedures used in establishing the the corner positions and monumentation found or placed.)


Monument Description and Remarks: SW Cor. NW¼ NE¼ - Set yellow CIR #6808 exposed on line between found N¼ Cor and Center of Section. N. & S. Location determined by prorating original Survey dimensions to current measured dimensions on E. Line NE¼ sec. and W. line NW¼ and projecting straight line across full Section.


SE Cor. NW¼ NE¼ - Set yellow CIR #6808 at mid point on line between SW Cor. NW¼ NE¼ and SE COR NE¼ NE¼.


PLAN - VIEW

(Show a minimum of three reference ties to durable physical objects, relevant monuments and physical conditions that will enable recovery of the corner.)

N.E. COR NW¼ NE¼ - Set yellow CIR #6808 at midpoint on line between found N¼ Cor. and found NE cor. of Section.

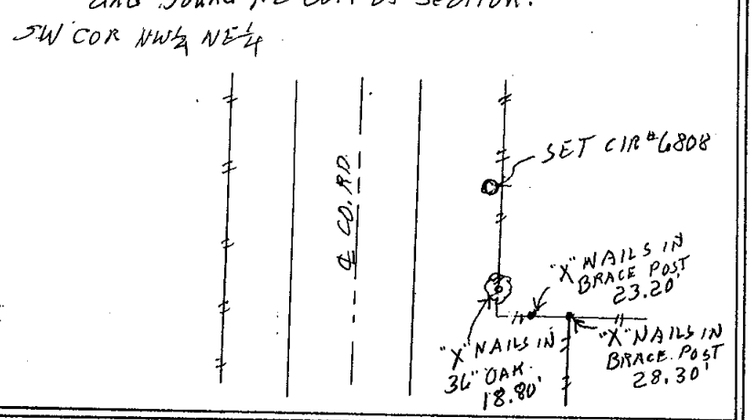

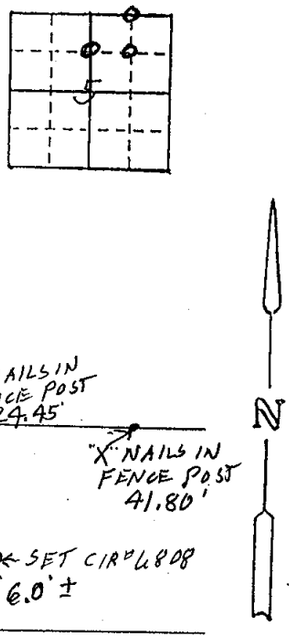

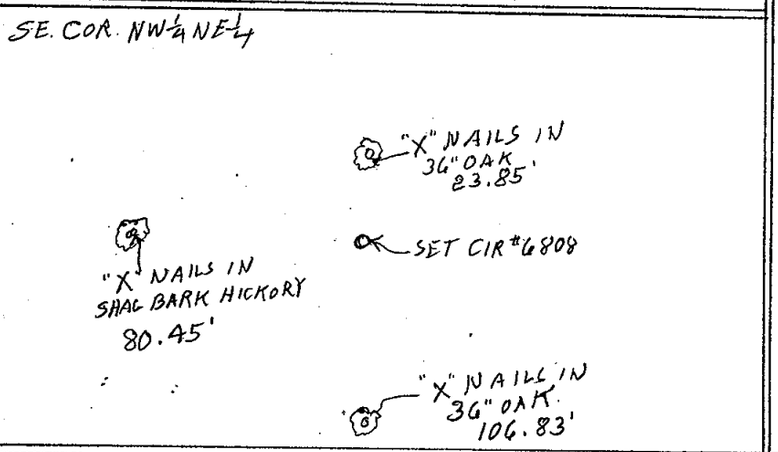

LICENSED LAND SURVEYOR
J. M. HOCHSTETLER
6808
IOWA

I hereby certify that this land surveying document was prepared and the related survey work was performed by me or under my direct personal supervision and that I am a duly licensed Land Surveyor under the laws of the State of Iowa.

J.M. Hochstetler
J.M. HOCHSTETLER
License number 6808 Date 7/9/01
My license renewal date is December 31, 2001
Pages or sheets covered by this seal: 1

List Corners to be Indexed

Corners	Section	Twp	Range
SW COR NW¼ NE¼	5	75N	27W
SE COR NW¼ NE¼	5	75N	27W
NE COR NW¼ NE¼	5	75N	27W