


REC \$ 5⁰⁰
AUD \$
R.M.F. \$ 1⁰⁰

COMPUTER ☒
RECORDED ☒
COMPARED ☐

FILED NO. 003864
BOOK 2001 PAGE 3864
2001 AUG 29 PM 3:28


VANCE & HOCHSTETLER, P.C. CONSULTING ENGINEERS, WINTERSET, IOWA (515) 462-3995
CHARLES T. VANCE, 110 WEST GREEN ST., WINTERSET, IOWA 50273
JAMES M HOCHSTETLER, 110 WEST GREEN ST., WINTERSET, IOWA 50273

PLAT OF SURVEY OF LOTS 5, 6, AND THE WEST 42 FEET OF
LOT 7, BLOCK 17, LAUGHRIDGE & CASSIDAY'S ADDITION,
CITY OF WINTERSET, MADISON COUNTY, IOWA
FOR JOE SAXTON.

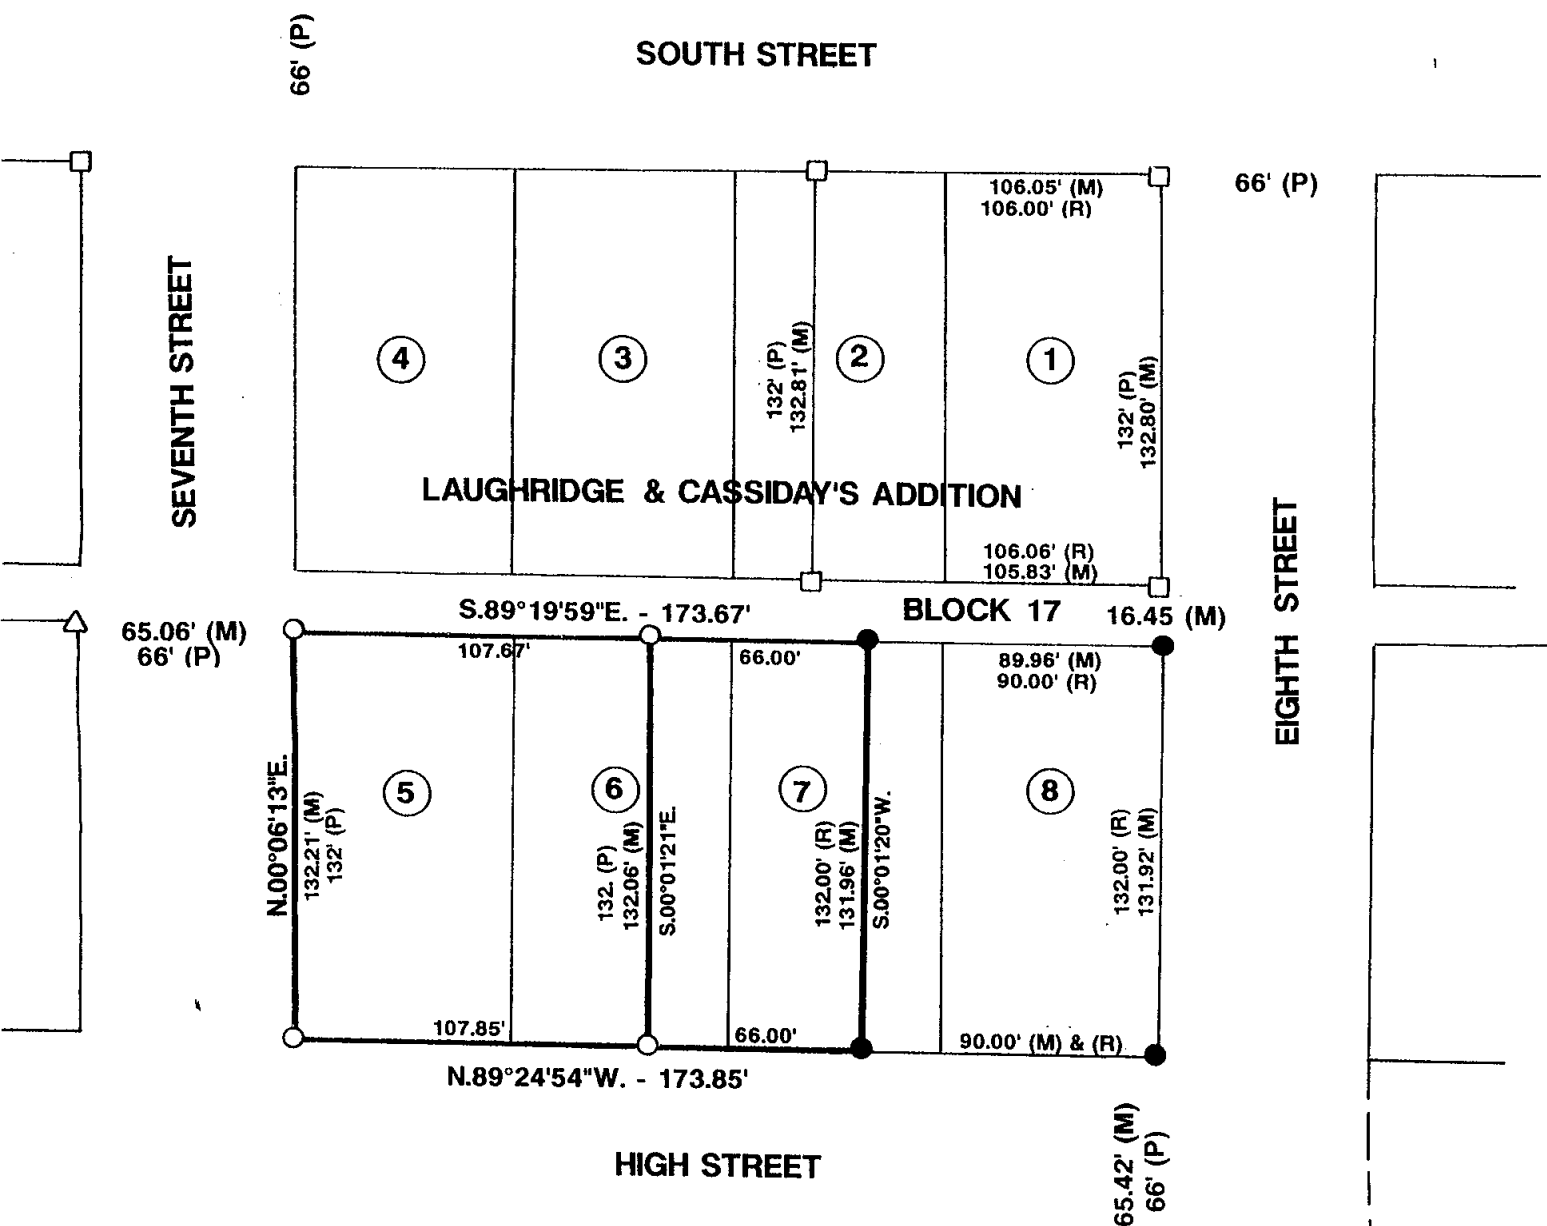

- CAPPED IRON ROD (CIR) #6808 SET
- C.I.R. #5041 FOUND
- 5/8" IRON ROD FOUND
- △ CIR #6808 FOUND
- (M) MEASURED DISTANCE
- (P) PLATTED DISTANCE
- (R) RECORDED DISTANCE

0 20' 40' 60' 80' 100' 120'
SCALE 1" = 60'
DATE OF SURVEY = 8/6/01

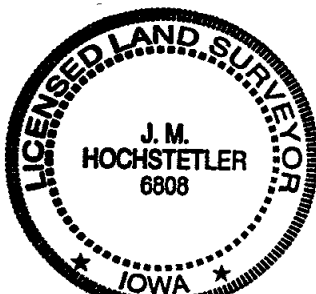

I hereby certify that this land surveying document
was prepared and the related survey work was
performed by me or under my direct personal
supervision and that I am a duly licensed Land
Surveyor under the laws of the State of Iowa.

J.M. HOCHSTETLER
License number 6808 Date 8/20/01
My license renewal date is December 31, 2001
Pages or sheets covered by this seal: 1