
BOOK 2001 PAGE 3889

REC \$ 50 AUD \$ R.M.F. \$ 100 COMPUTER V
RECORDED V
COMPARED

2001 AUG 30 PM 3: 26

MICKI UTSLER RECORDER

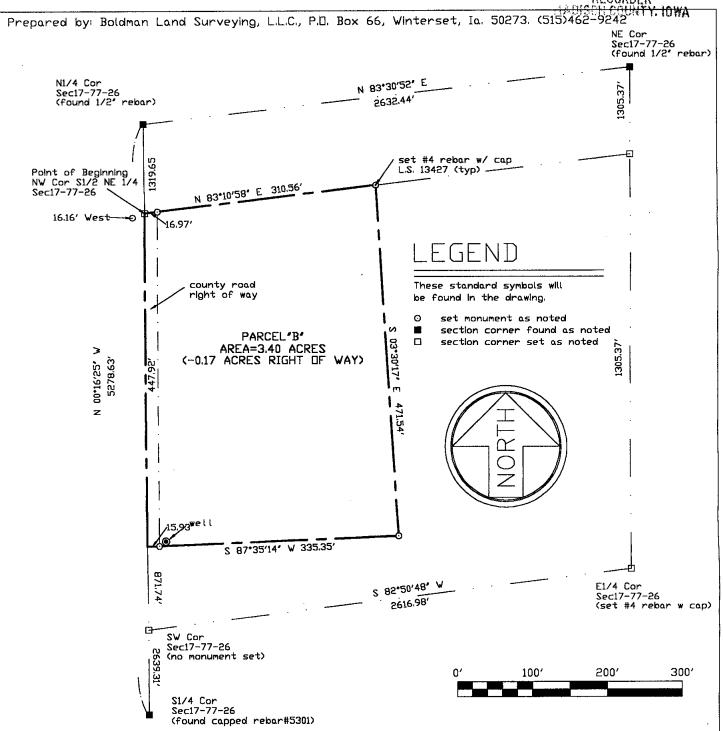

Madison County, Iowa, more particularly described as follows:

Parcel 'B'-Part of the South 1/2 of the Northeast 1/4 of Section 17, Township 77 North, Range 26 West of the 5th P.M.,

Beginning At The Northwest Corner Of The South 1/2 of The Northeast 1/4 Of Sald Section 17; Thence N 83 DEGREES 10 MINUTES 58 SECONDS E A Distance Of 310.56'; Thence S 03 DEGREES 30 MINUTES 17 SECONDS E A Distance Of 471.54'; Thence S 87 DEGREES 35 MINUTES 14 SECONDS W A Distance Of 335.35'; Thence N 00 DEGREES 16 MINUTES 25 SECONDS W A Distance Of 447.92';

to the point of beginning,

Containing 3.40 Acres of Land Including 0.17 Acres of County Road Right of Way.



I HEREBY CERTIFY THAT THIS LIPREPARED AND THE RELATED SUIDER MY DIRECT PER I AM A DULY LICENSED LAND SUITHE STATE OF ITMA	RVEY WORK WAS PERFORMED RSONAL SUPERVISION AND THAT
NAME: CRAIG S. BOLLMAN DATE: 32 0 MY LICENSE RENEWAL DATE IS:	DECEMBER 31, 2002

ptat	of	survey
REQUESTED BY:		BOLDMAN LAND SURVEYING,L.L.C.
Iowa Realty	wa Realty P.D. BD	
SURVEYED	SCALE	WINTERSET, IA. 50273
3/31/01	1"=100'	(515)462-9242
PROJECT NO.	DATE	□ W NER
01008	8/30/01	Vernon King