REC $ 5.00
AUD $
R.M.F. $ 1.00

COMPUTER ✓
RECORDED ✓
COMPARED

FILED NO 004368
BOOK 2001 PAGE 4368
2001 SEP 28 AM 8:42

MICKI UTSLER
RECORDER
MADISON COUNTY, IOWA

VANCE & HOCHSTETLER, P.C., CONSULTING ENGINEERS, WINTERSET, IOWA (515) 462-3995
01-1285
CHARLES T. VANCE, 110 West Green St., Winterset, Iowa, 50273
JAMES M HOCHSTETLER, 110 West Green St., Winterset, Iowa 50273

UNITED STATES PUBLIC LAND SURVEY CORNER CERTIFICATE OF

Land Survey Monuments situated in Section 32, Township 76 North, Range 26 West, of the Fifth Principal Meridian, MADISON County, Iowa.
Previously recorded in _____ in County Recorder's Office.
(book, page, document number, etc.)

(Show reason for preparing this certificate, the evidence and detailed procedures used in establishing the the corner positions and monumentation found or placed.)


Monument Description and Remarks:

NW corner NE. 1/4 SE. 1/4 - Set Capped Iron Rod #6808 (1/2" rebar, exposed) at existing property line fence corner.
SW cor. SE. 1/4 SE. 1/4 - Set C.I.R. #6808 (1/2" rebar, 4" deep) at the midpoint of the S. line of the SE. 1/4, which lines up with a property line fence to the North


PLAN - VIEW


(Show a minimum of three reference ties to durable physical objects, relevant monuments and physical conditions that will enable recovery of the corner.)

NW CORNER
NE. 1/4 SE. 1/4
SEC. 32-76-26
Set C.I.R. #6808

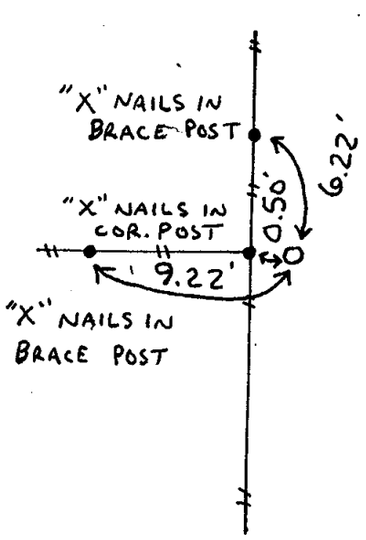

SW CORNER
SE. 1/4 SE. 1/4
SEC. 32-76-26
Set C.I.R. # 6808

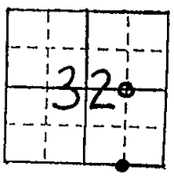

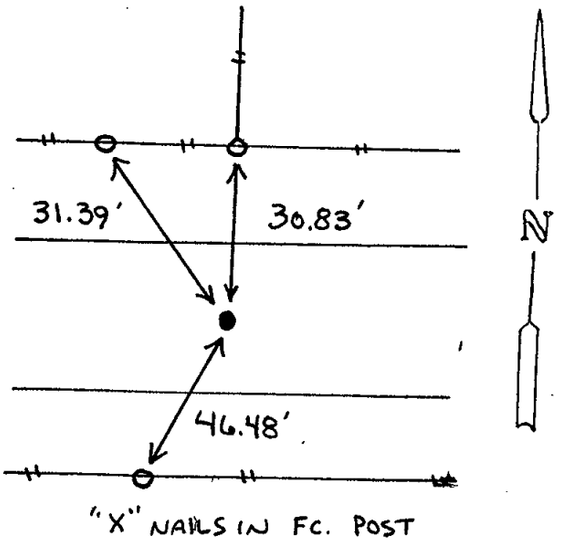

LICENSED LAND SURVEYOR
J. M. HOCHSTETLER
6808
IOWA

I hereby certify that this land surveying document was prepared and the related survey work was performed by me or under my direct personal supervision and that I am a duly licensed Land Surveyor under the laws of the State of Iowa.

J.M. HOCHSTETLER
License number 6808 Date 9/21/01
My license renewal date is December 31, 2001
Pages or sheets covered by this seal: 1

List Corners to be Indexed

Corners	Section	Twp	Range
NW cor. NE. 1/4 SE. 1/4	32	76N	26W
SW cor. SE. 1/4 SE. 1/4	32	76N	26W