005348

FILED NO. _____

BOOK 2001 PAGE 5348

2001 NOV 29 AM 11: 12

MICKI UTSLER
RECORDER
MADISON COUNTY, IOWA

REC $ 5.00
AUD $ _____
R.M.F. $ 1.00

COMPUTER ✓
RF [illegible] ✓
COMPARED _____

VANCE & HOCHSTETLER, P.C., CONSULTING ENGINEERS, WINTERSET, IOWA (515) 462-3995
01-2045 CHARLES T. VANCE, 110 West Green St., Winterset, Iowa, 50273
JAMES M HOCHSTETLER, 110 West Green St., Winterset, Iowa 50273

# UNITED STATES PUBLIC LAND SURVEY CORNER CERTIFICATE

Land Survey Monuments situated in Section 27 OF, Township 76 North, Range 26 West, of the Fifth Principal Meridian, MADISON County, Iowa.
Previously recorded in _____ in County Recorder's Office.
(book, page, document number, etc.)

(Show reason for preparing this certificate, the evidence and detailed procedures used in establishing the the corner positions and monumentation found or placed.)


Monument Description and Remarks:

NE cor. SE.1/4 NW.1/4 - Set Capped Iron Rod #6808 (1/2" rebar, 1" deep) at midpoint of the E. line of the NW.1/4 of Section 27.
NW cor. SW.1/4 NW.1/4 - Set C.I.R. #6808 (1/2" rebar, 6" deep) at the one-quarter point of the West line of Section 27.


## PLAN - VIEW


(Show a minimum of three reference ties to durable physical objects, relevant monuments and physical conditions that will enable recovery of the corner.)

NE CORNER
SE.1/4 NW.1/4
SEC. 27-76-26
Set C.I.R. #6808

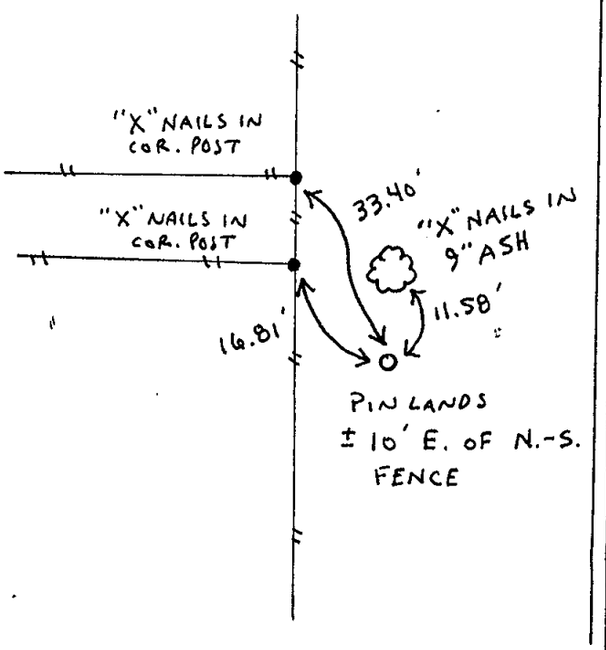


NW CORNER
SW.1/4 NW.1/4
SEC. 27-76-26
Set C.I.R. #6808

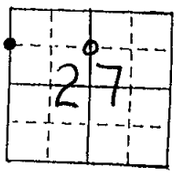

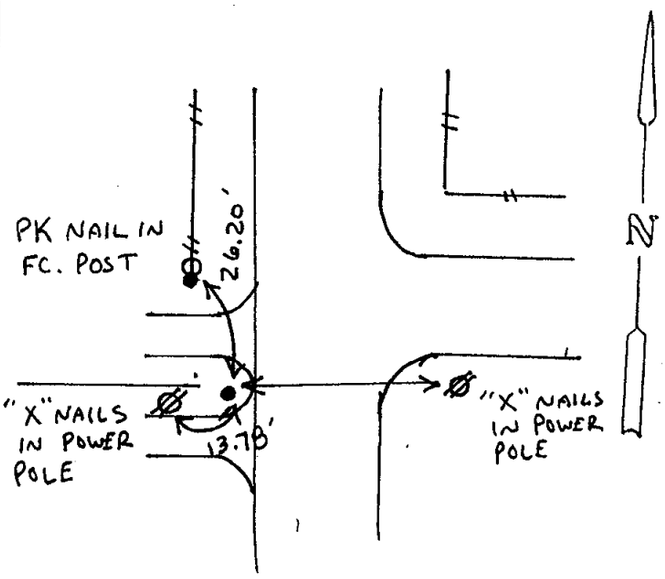
LICENSED LAND SURVEYOR
J. M. HOCHSTETLER
6808
IOWA

I hereby certify that this land surveying document was prepared and the related survey work was performed by me or under my direct personal supervision and that I am a duly licensed Land Surveyor under the laws of the State of Iowa.

J.M. Hochstetler

J.M. HOCHSTETLER
License number 6808 Date 11/14/01
My license renewal date is December 31, 2001
Pages or sheets covered by this seal: 1

List Corners to be Indexed

| Corners | Section | Twp | Range |
|---|---|---|---|
| NE cor. SE.1/4 NW.1/4 | 27 | 76N | 26W |
| NW cor. SW.1/4 NW.1/4 | 27 | 76N | 26W |