FILED NO. 005047

BOOK 2001 PAGE 5047

REC $ 5.00
AUD $
R.M.F. $ 1.00

COMPUTER ✓
RECORDED ✓
COMPARED

2001 NOV -8 AM 10: 29

MICKI UTSLER
RECORDER
MADISON COUNTY, IOWA

VANCE & HOCHSTETLER, P.C., CONSULTING ENGINEERS, WINTERSET, IOWA (515) 462-3995
01-1825 CHARLES T. VANCE, 110 West Green St., Winterset, Iowa, 50273
JAMES M HOCHSTETLER, 110 West Green St., Winterset, Iowa 50273

UNITED STATES PUBLIC LAND SURVEY CORNER CERTIFICATE

OF

Land Survey Monuments situated in Section 1, Township 77 North, Range 27 West, of the Fifth Principal Meridian, MADISON County, Iowa.
Previously recorded in _____ in County Recorder's Office.
(book, page, document number, etc.)

(Show reason for preparing this certificate, the evidence and detailed procedures used in establishing the the corner positions and monumentation found or placed.)


Monument Description and Remarks:

Center - Fd. 5/8" Iron Pipe (6" deep) at 4-way road intersection. Corner was previously found by the Madison County Engineer's office
W. 1/4 cor. - Fd. 1/2" Iron Rod (4" deep) in roadway (previously found by Mad. Co. Engineers Office).

PLAN - VIEW


(Show a minimum of three reference ties to durable physical objects, relevant monuments and physical conditions that will enable recovery of the corner.)


CENTER
SEC. 1-77-27
Fd. 5/8" Iron Pipe

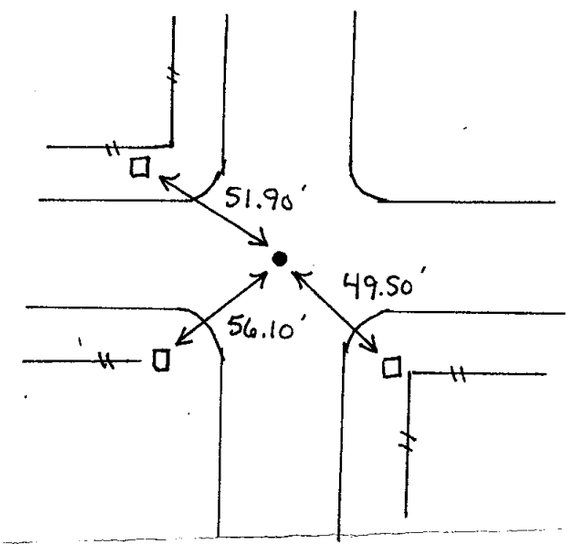

ALL TIES ARE TO FOUND GRADER BLADES

WEST 1/4 COR.
SEC. 1-77-27
Fd. 1/2" Iron Rod

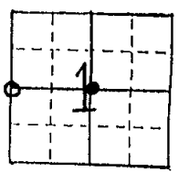

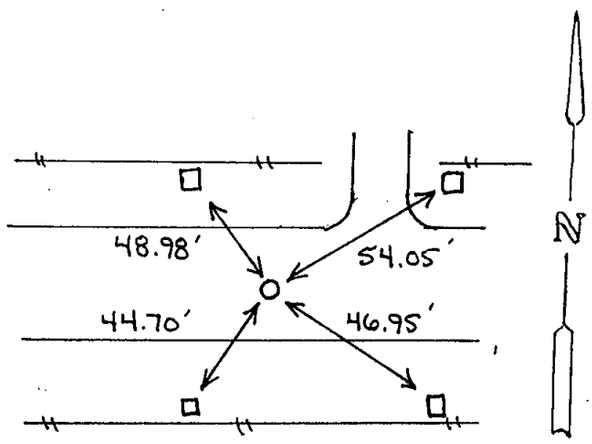

ALL TIES ARE TO FOUND GRADER BLADES

LICENSED LAND SURVEYOR
J. M. HOCHSTETLER
6808
IOWA

I hereby certify that this land surveying document was prepared and the related survey work was performed by me or under my direct personal supervision and that I am a duly licensed Land Surveyor under the laws of the State of Iowa.

J.M. Hochstetler

J.M. HOCHSTETLER
License number 6808 Date 11/1/01.
My license renewal date is December 31, 2001
Pages or sheets covered by this seal: 1

List Corners to be Indexed

Corners	Section	Twp	Range
Center	1	77N	27W
W. 1/4 cor.	1	77N	27W