

FILED NO. **000129**

BOOK **2002** PAGE **129**

2002 JAN -9 PM **12:46**

REC \$ **5.00**
AUD \$
R.M.F. \$ **1.00**

COMPUTER
RECORDED
COMPARED

NICKI UTSLER
RECORDER
MADISON COUNTY, IOWA

Prepared By: J. Brian Morrissey, Morrissey Surveying, 1405 Highway G28, Otley, Iowa 50214, Tel. (641) 627-5854

UNITED STATES PUBLIC LAND SURVEY CORNER CERTIFICATE OF



Land Survey Monuments situated in Section 29, Township 75 N, Range 28 W, of the Fifth Principal Meridian, Madison County, Iowa.
Previously recorded in Book 1, Page 416 in County Recorders Office.
(book, page, document number, etc.)

(Show reason for preparing this certificate, the evidence and detailed procedures used in establishing the corner positions and monumentation found or placed.)

Monument Description and Remarks: Found 1" iron pin. The reason for preparing this certificate is because two of the three previously recorded ties were missing. Placed new ties. Accepted position.

PLAN VIEW

(Show a minimum of three reference ties to durable physical objects, relevant monuments and physical conditions that will enable recovery of the corner.)

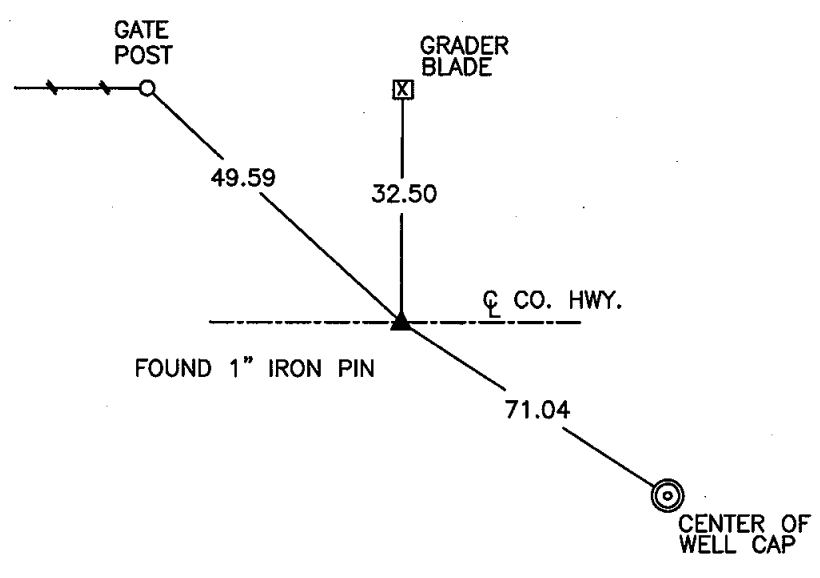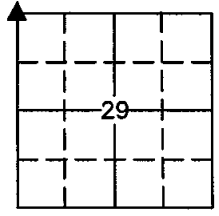

NW. COR., SEC. 29

NOTE: ALL TIES TO "X" NAILS UNLESS NOTED.



I hereby certify that the survey work was completed and this certificate was prepared by me or under my direct personal supervision and that I am a duly Licensed Land Surveyor under the laws of the State of Iowa.

Signature: J. Brian Morrissey Date: 1/7/02
J. Brian Morrissey

License number 7995.
My license renewal date is December 31, 2003.