000216

FILED NO. _____

BOOK 2002 PAGE 216

2002 JAN 15 AM 8:10

MICKI UTSLER
RECORDER
MADISON COUNTY, IOWA

COMPUTER ✓
RECORDED ✓
COMPARED ✓

REC $ 5.00
AUD $ _____
R.M.F. $ 1.00

VANCE & HOCHSTETLER, P.C., CONSULTING ENGINEERS, WINTERSET, IOWA (515) 462-3995
01-2085 CHARLES T. VANCE, 110 West Green St., Winterset, Iowa, 50273
JAMES M HOCHSTETLER, 110 West Green St., Winterset, Iowa 50273

UNITED STATES PUBLIC LAND SURVEY CORNER CERTIFICATE

OF


Land Survey Monuments situated in Section 34, Township 77 N, Range 26 W, of the Fifth Principal Meridian, MADISON County, Iowa.
Previously recorded in _____ in County Recorder's Office.
(book, page, document number, etc.)

(Show reason for preparing this certificate, the evidence and detailed procedures used in establishing the the corner positions and monumentation found or placed.)

Monument Description and Remarks: CENTER SEC. 34-77-26 - FOUND NAIL AT ℄ E. & W. COUNTY ROAD & ℄ MINIMUM MAINTENANCE ROAD NORTH. NAIL ALSO SHOWN AS FOUND ON A SURVEY BY CHARLES VANCE IN 1988. SET YELLOW CIR #6808 AT LOCATION OF NAIL.

PLAN - VIEW

(Show a minimum of three reference ties to durable physical objects, relevant monuments and physical conditions that will enable recovery of the corner.)

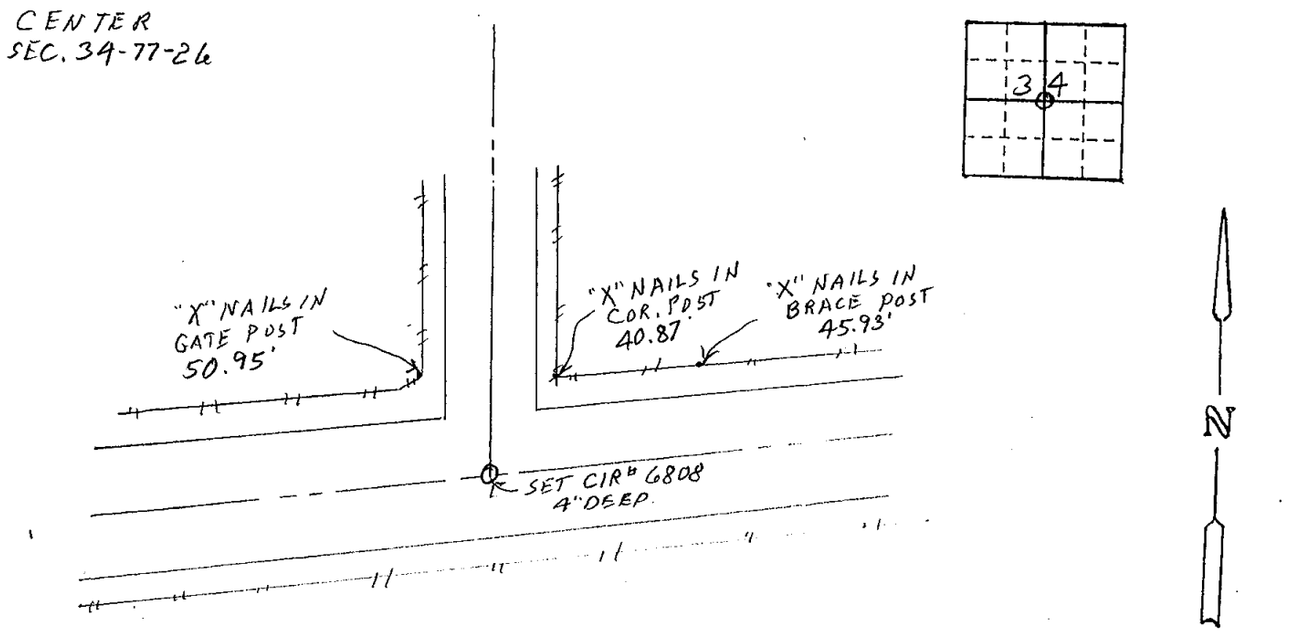

J. M. HOCHSTETLER 6808 LICENSED LAND SURVEYOR IOWA

I hereby certify that this land surveying document was prepared and the related survey work was performed by me or under my direct personal supervision and that I am a duly licensed Land Surveyor under the laws of the State of Iowa.

J.M. HOCHSTETLER
License number 6808 Date 1/8/02.
My license renewal date is December 31, 2003
Pages or sheets covered by this seal: 1

List Corners to be Indexed

Corners	Section	Twp	Range
CENTER	34	77N	26W