FILED NO. 000222
BOOK 2002 PAGE 222
2002 JAN 15 AM 8:16
MICKI UTSLER
RECORDER
MADISON COUNTY, IOWA

REC $ 5.00
AUD $
R.M.F. $ 1.00

COMPUTER ✓
RECORDED ✓
COMPARED ✓

VANCE & HOCHSTETLER, P.C., CONSULTING ENGINEERS, WINTERSET, IOWA (515) 462-3995
01-505 CHARLES T. VANCE, 110 West Green St., Winterset, Iowa, 50273
JAMES M HOCHSTETLER, 110 West Green St., Winterset, Iowa 50273

UNITED STATES PUBLIC LAND SURVEY CORNER CERTIFICATE

OF

Land Survey Monuments situated in Section 11, Township 76 N, Range 26 W, of the Fifth Principal Meridian, MADISON County, Iowa.
Previously recorded in _____ in County Recorder's Office.
(book, page, document number, etc.)


(Show reason for preparing this certificate, the evidence and detailed procedures used in establishing the the corner positions and monumentation found or placed.)


Monument Description and Remarks: NW COR. - Set CIR. #6808, yellow cap exposed in creek - Set at intersection of line through found N¼ Cor and NE COR. NW¼NW¼ with old existing property line fence along the West line of NW¼.

SW Cor. NW¼ NW¼ - Set yellow CIR #6808 exposed at intersection of line through found SE COR NE¼NW¼ and SW COR. NE¼ NW¼ with old existing property line fence along the West line of NW¼.

PLAN - VIEW

(Show a minimum of three reference ties to durable physical objects, relevant monuments and physical conditions that will enable recovery of the corner.)

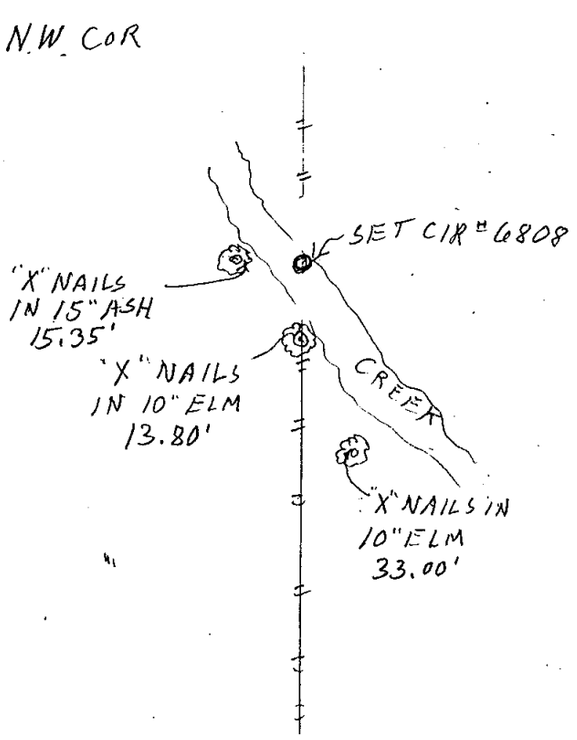

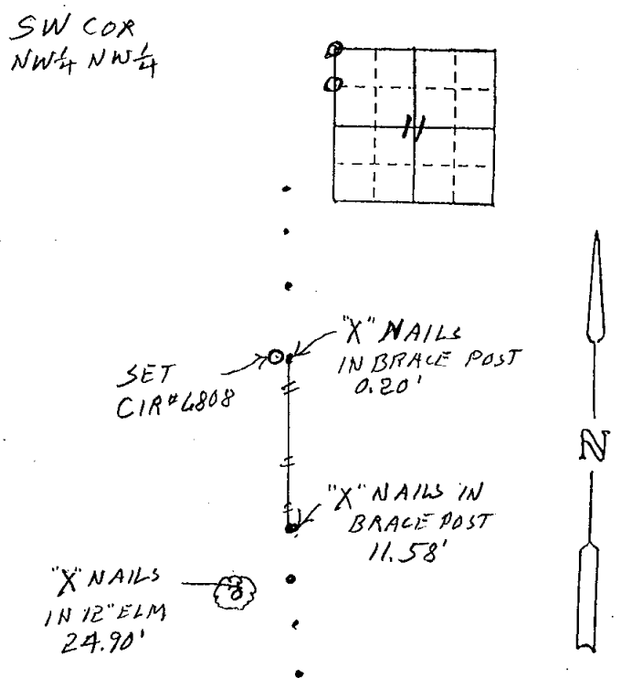

I hereby certify that this land surveying document was prepared and the related survey work was performed by me or under my direct personal supervision and that I am a duly licensed Land Surveyor under the laws of the State of Iowa.

J.M. HOCHSTETLER
License number 6808 Date 11/23/01
My license renewal date is December 31, 2001
Pages or sheets covered by this seal: 1

LICENSED LAND SURVEYOR
J. M. HOCHSTETLER
6808
IOWA

List Corners to be Indexed

Corners	Section	Twp	Range
NW COR	11	76N	26W
SW COR NW¼ NW¼	11	76N	26W