

REC \$ No
AUD \$ Fee
R.M.F. \$

COMPUTER
RECORDED
COMPARED

MICKI UTSLER
RECORDER

Prepared By: Michael James Hackett, Madison County Engineer's Office, Courthouse, P.O. Box 152, Winterset, Ia. 50273-1521

UNITED STATES PUBLIC LAND SURVEY CORNER CERTIFICATE OF

Land Survey Monuments situated in Section 4, Township 75 N, Range 29 W, of the Fifth Principal Meridian, Madison County, Iowa. Previously recorded in Book 1, Page 8 in County Recorder's Office. (book, page, document number, etc.)



(Show reason for preparing this certificate, the evidence and detailed procedures used in establishing the corner positions and monumentation found or placed.)

Monument Description and Remarks: "A" Section Corner: Found 3/8" rebar in concrete in concrete monument. Reset with P.K. nail in asphalt concrete pavement. The found Found 3/8" rebar in concrete in concrete monument was disturbed during the construction of Madison County Highway Project STP-S-C061(60)--5E-61. A P.K. nail was reset from ties. Accepted position as the southeast corner of the Northeast Quarter based on the tie information from D. A. Sparks R.L.S. No. 3436, Iowa State Highway Commissions Land Corner Survey dated 12/29/1965 and Madison County Project No. RS-6288(3)--61-61 field book dated 8/1/83 logged by the County Engineer's Office.

"B" Road P.I.: Found 3/8" rebar. Reset with P.K. nail in asphalt concrete pavement, used for project road P.I. The found Found 3/8" rebar was not accepted because of the monument description and ties were not consistent with the corner tie history logged by the County Engineer's Office.

PLAN VIEW

(Show a minimum of three reference ties to durable physical objects, relevant monuments and physical conditions that will enable recovery of the corner.)

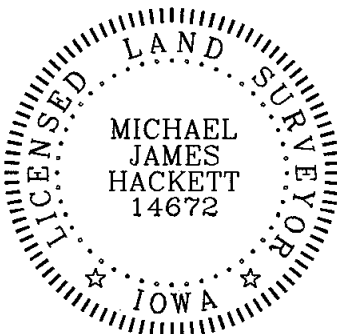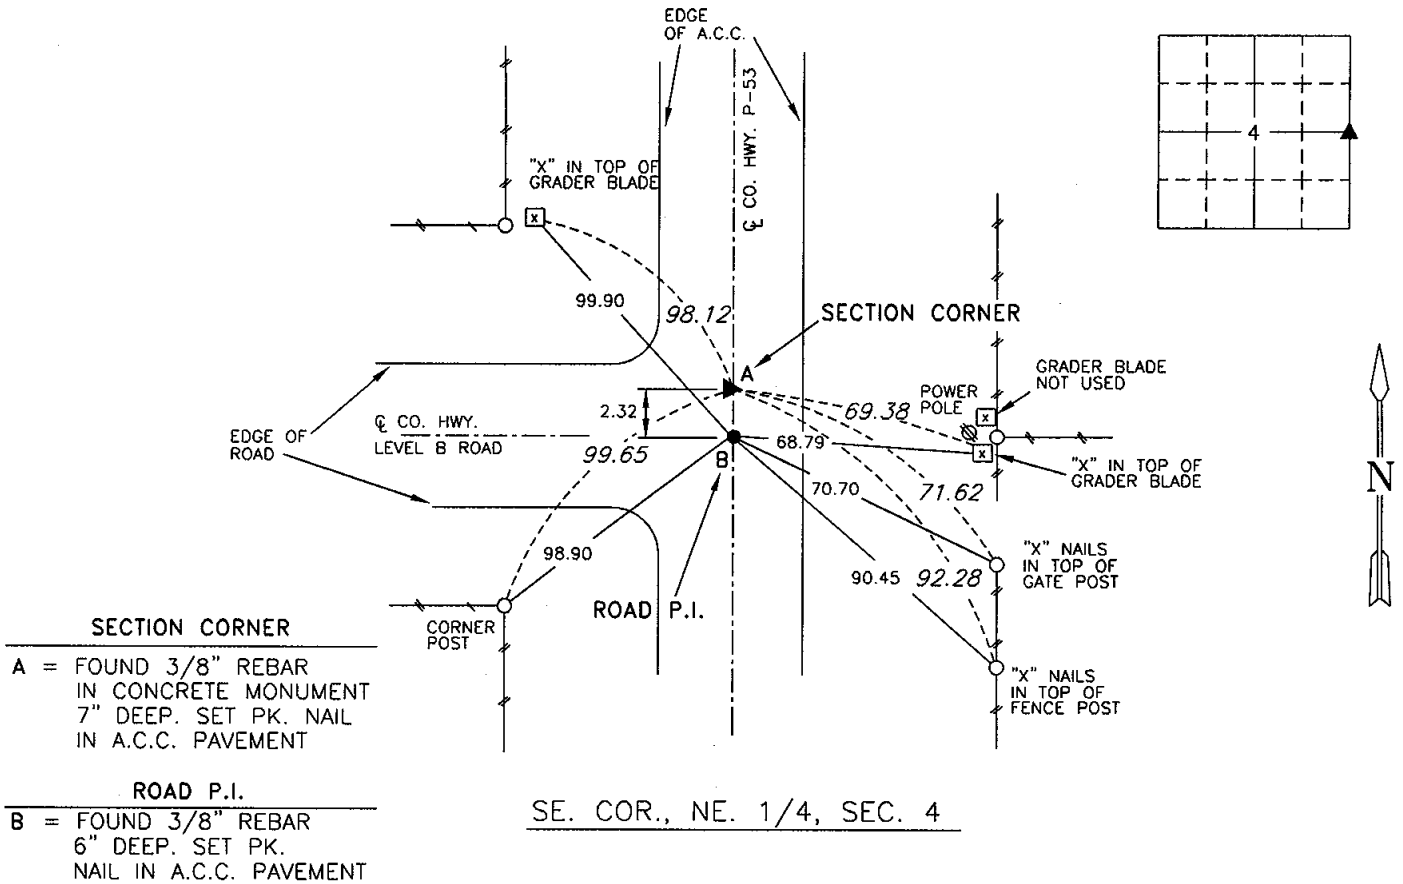

I hereby certify that this land surveying document was prepared and the related survey work was performed by me or under my direct personal supervision and that I am a duly Licensed Land Surveyor under the laws of the State of Iowa.

Signed Michael James Hackett Date 1-21-2002
Michael James Hackett Iowa Lic. No. 14672

My license renewal date is 12/31/2002.
Pages covered by this seal: 1.