

NICKI WISLER
RECORDER
MADISON COUNTY, IOWA

REC \$ 5.00
AUD \$ _____
R.M.F. \$ 1.00

COMPUTER
RECORDED
COMPARED _____

RETURN TO: ✓ BOLDMAN LAND SURVEYING, P.C., BOX 66, WINTERSSET, IA 50273 515-462-9242
UNITED STATES PUBLIC LAND SURVEY CORNER CERTIFICATE


OF
Land Survey Monuments situated in Section 3, Township 75 N, Range 28 W,
of the Fifth Principal Meridian, MADISON County, Iowa
Previously recorded in NONE in County Recorder's Office.
(book, page, document number, etc.)

(show reason for preparing this certificate, the evidence and detailed procedures used in establishing the corner positions and monumentation found or placed.)

Monument Description and Remarks: ① Found #4 pin 15" below road according to notes in Corner Stone Book. ② Found #5 pin 12" below pavement according to 1934 paving plans. Tied off and re-set #4 pin w/cap above pin.

PLAN-VIEW

(Show a minimum of three reference ties to durable physical objects, relevant monuments and physical conditions that will enable recovery of the corner.)

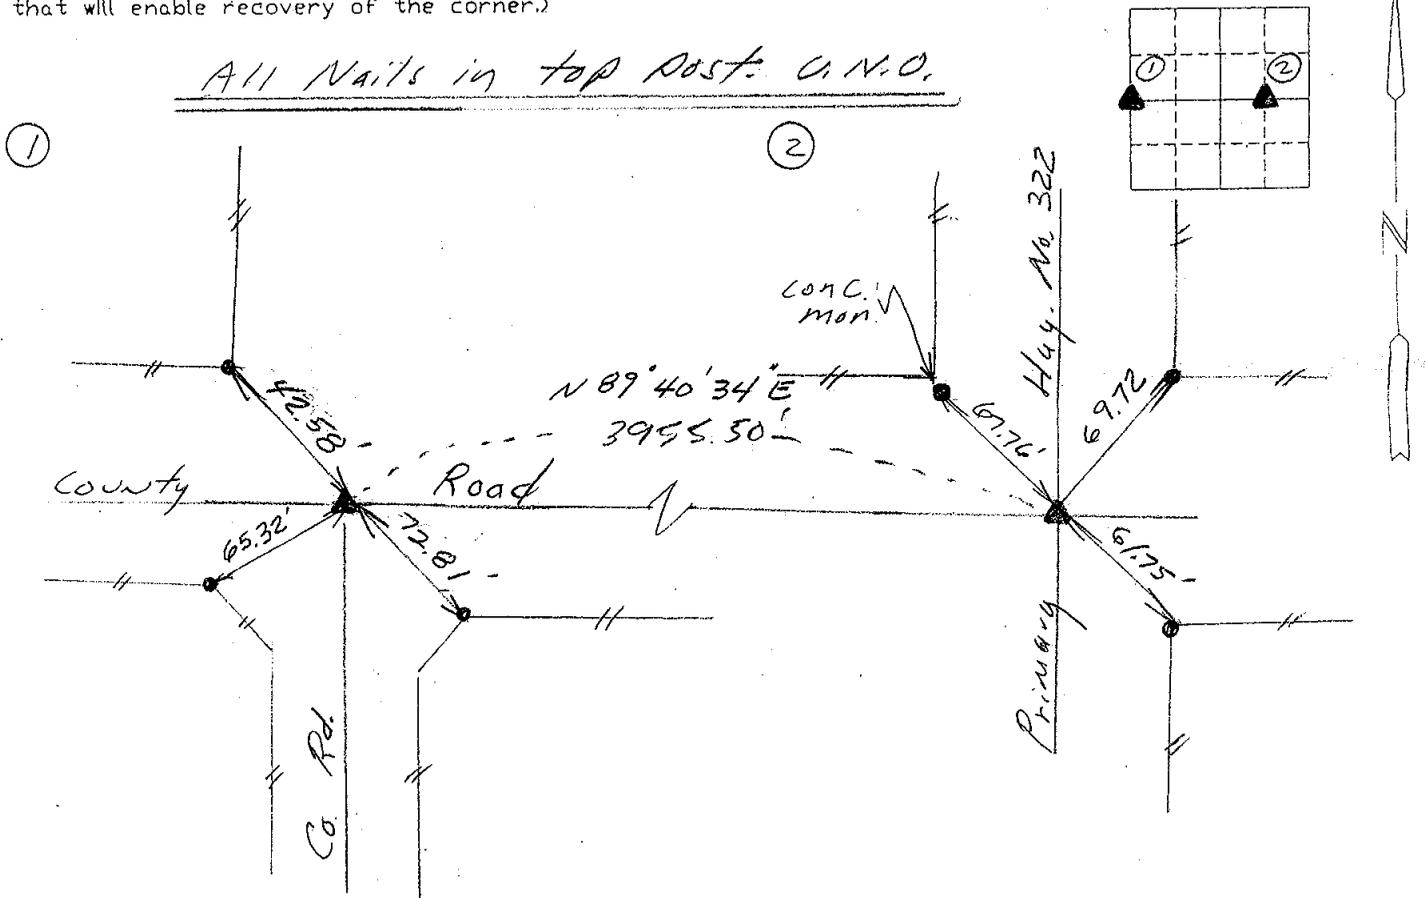


I hereby certify that the survey work was completed and this certificate was prepared by me or under my direct personal supervision and that I am a duly Licensed Land Surveyor under the laws of the State of Iowa

Signature: Craig S. Boldman
Craig S. Boldman

Date: 1/31/02 Reg. No. 13427

exp. 12/31/02

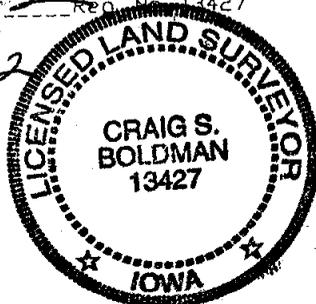

SEAL

List Corners to be Indexed

Corners	Section	Twp	Range
W 1/4	3	75	28
S 1/4 NE 1/4	"	"	"