

REC \$ 5⁰⁰
AUD \$ 1⁰⁰
R.M.F. \$ 1⁰⁰

COMPUTER ☒
RECORDED ☒
COMPARED ☐

MICKI UTSLER
RECORDER
MADISON COUNTY, IOWA
PH: (515) 276-0467

PREPARED BY: JOEL R. ROMNEY 3501 104th STREET URBANDALE IOWA 50322


UNITED STATES PUBLIC LAND SURVEY CORNER CERTIFICATE
OF

Land Survey Monuments situated in Section 32, Township 77 N, Range 26 W, of the Fifth Principal Meridian, MADISON County, Iowa.
Previously recorded in Book NONE, Page NONE.

(Show reason for preparing this certificate, the evidence and detailed procedures used in establishing the corner positions and monumentation found or placed).

Monument Description and Remarks:

*NO EXISTING CORNER CERTIFICATE IS ON FILE AT THE
MADISON COUNTY RECORDER'S OFFICE. ADDITIONAL
INFORMATION CAN BE FOUND ON BISHOP ENGINEERING
DRAWING No. 01-18P.*

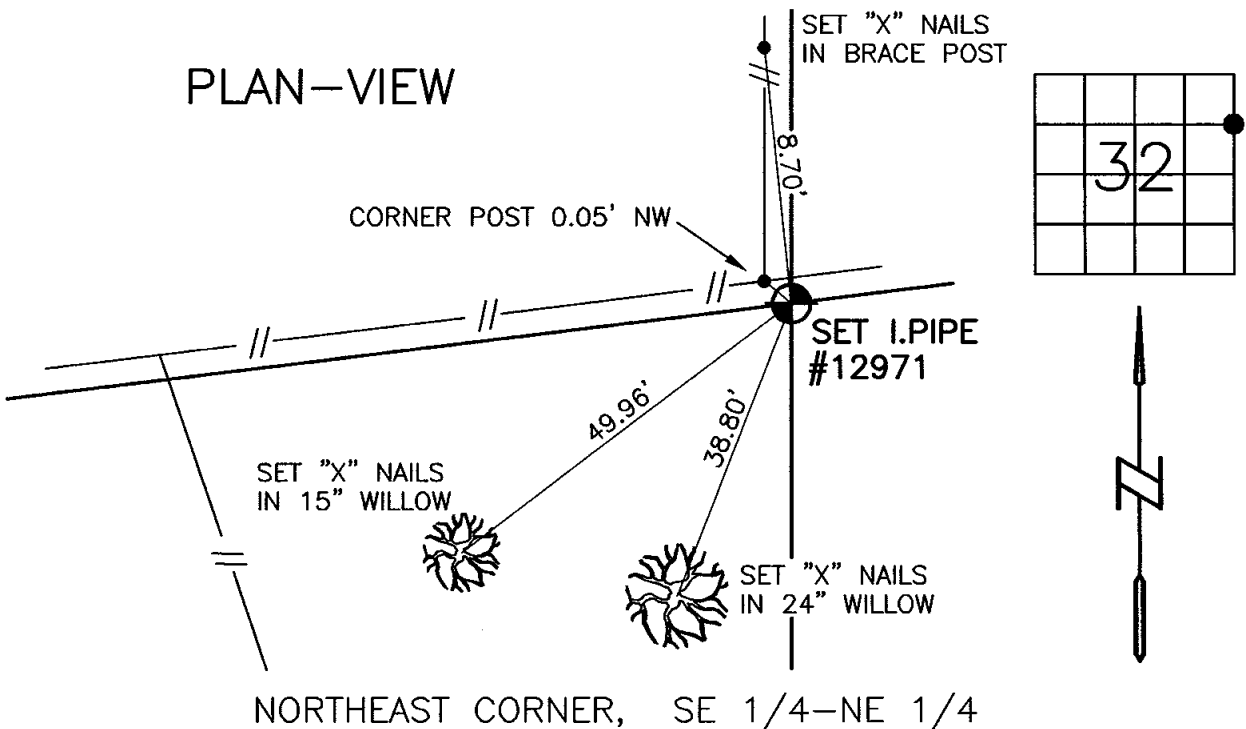


I hereby certify that the survey work was completed and this certificate was prepared by me or under my direct personal supervision and that I am a duly licensed land surveyor under the laws of the state of Iowa.

Joel R. Romney 02/04/02

Licensed Land Surveyor No.
License Renewal Date: 31 Dec. 2003

SEAL

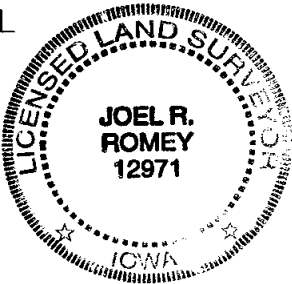

List Corners to be indexed

Corners	Section	Twp	Range
NE CORNER SE 1/4-NE 1/4	32	77	26