FILED NO. 001611

REC $ 5.00
AUD $ ____
R.M.F. $ 1.00

COMPUTER ✓
RECORDED ✓
COMPARED ____

BOOK 2002 PAGE 1611

2002 APR -4 PM 2:23

MICKI UTSLER
RECORDER
MADISON COUNTY, IOWA

J

VANCE & HOCHSTETLER, P.C., CONSULTING ENGINEERS, WINTERSET, IOWA (515) 462-3995
02-375 CHARLES T. VANCE, 110 West Green St., Winterset, Iowa, 50273
JAMES M HOCHSTETLER, 110 West Green St., Winterset, Iowa 50273

UNITED STATES PUBLIC LAND SURVEY CORNER CERTIFICATE

OF

Land Survey Monuments situated in Section 23, Township 76 North, Range 29 West, of the Fifth Principal Meridian, MADISON County, Iowa.
Previously recorded in _____ in County Recorder's Office.
(book, page, document number, etc.)

(Show reason for preparing this certificate, the evidence and detailed procedures used in establishing the the corner positions and monumentation found or placed.)


Monument Description and Remarks:

S. 1/4 cor. - Set Yellow Capped Iron Rod #6808 (1/2" rebar, 4" deep) at road R.O.W. split in line with property line fences to North & South.

SW cor. SE. 1/4 SE. 1/4 - Set Yellow C.I.R. #6808 (1/2" rebar, 4" deep) at midpoint of line between S. 1/4 cor. & SE corner (found square headed bolt).

PLAN - VIEW

(Show a minimum of three reference ties to durable physical objects, relevant monuments and physical conditions that will enable recovery of the corner.)

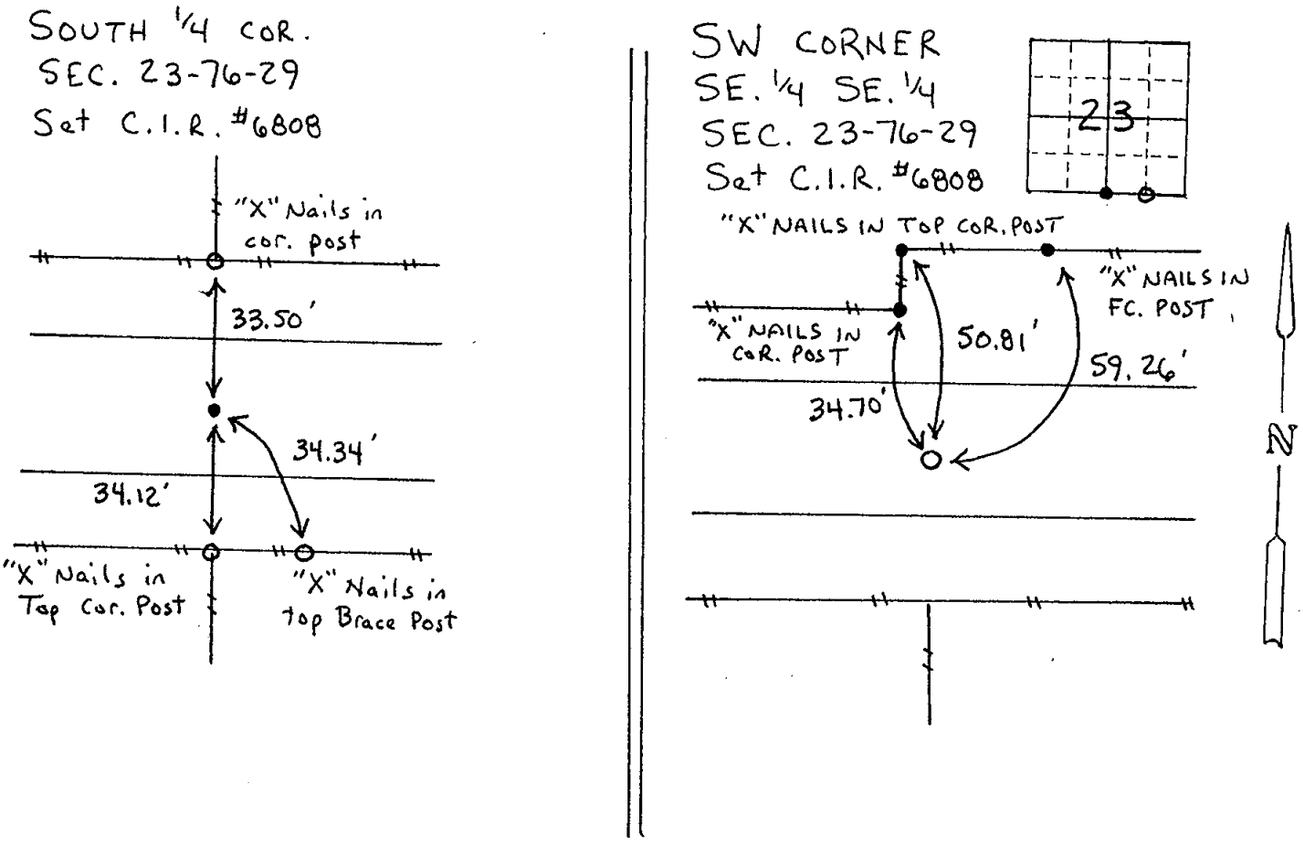

J. M. HOCHSTETLER 6808 — LICENSED LAND SURVEYOR — IOWA

I hereby certify that this land surveying document was prepared and the related survey work was performed by me or under my direct personal supervision and that I am a duly licensed Land Surveyor under the laws of the State of Iowa.

J.M. Hochstetler

J.M. HOCHSTETLER
License number 6808 Date 3/20/02
My license renewal date is December 31 2003
Pages or sheets covered by this seal: 1

List Corners to be Indexed

Corners	Section	Twp	Range
S. 1/4 cor.	23	76N	29W
SW cor SE. 1/4 SE. 1/4	23	76N	29W