001890

FILED NO. _____

BOOK 2002 PAGE 1890

2002 APR 22 AM 8:31

MICKI UTSLER
RECORDER
MADISON COUNTY, IOWA

REC $ 5.00
AUD $ _____
R.M.F. $ 1.00

COMPUTER ✓
RECORDED ✓
COMPARED _____

/

VANCE & HOCHSTETLER, P.C., CONSULTING ENGINEERS, WINTERSET, IOWA (515) 462-3995
02-45S CHARLES T. VANCE, 110 West Green St., Winterset, Iowa, 50273
JAMES M HOCHSTETLER, 110 West Green St., Winterset, Iowa 50273

UNITED STATES PUBLIC LAND SURVEY CORNER CERTIFICATE

Land Survey Monuments situated in Section 36, Township 76 North, Range 26 West, of the Fifth Principal Meridian, MADISON County, Iowa.
Previously recorded in _____ in County Recorder's Office.
(book, page, document number, etc.)


(Show reason for preparing this certificate, the evidence and detailed procedures used in establishing the the corner positions and monumentation found or placed.)

Monument Description and Remarks:

W. 1/4 cor. - Set Capped Iron Rod #6808 (1/2" rebar, exposed) on the projection of a line from the South, at the prorated one-third point of the distance between the SW cor. NW. 1/4 SW. 1/4 and the NW cor. (both referenced corners)

PLAN - VIEW

(Show a minimum of three reference ties to durable physical objects, relevant monuments and physical conditions that will enable recovery of the corner.)

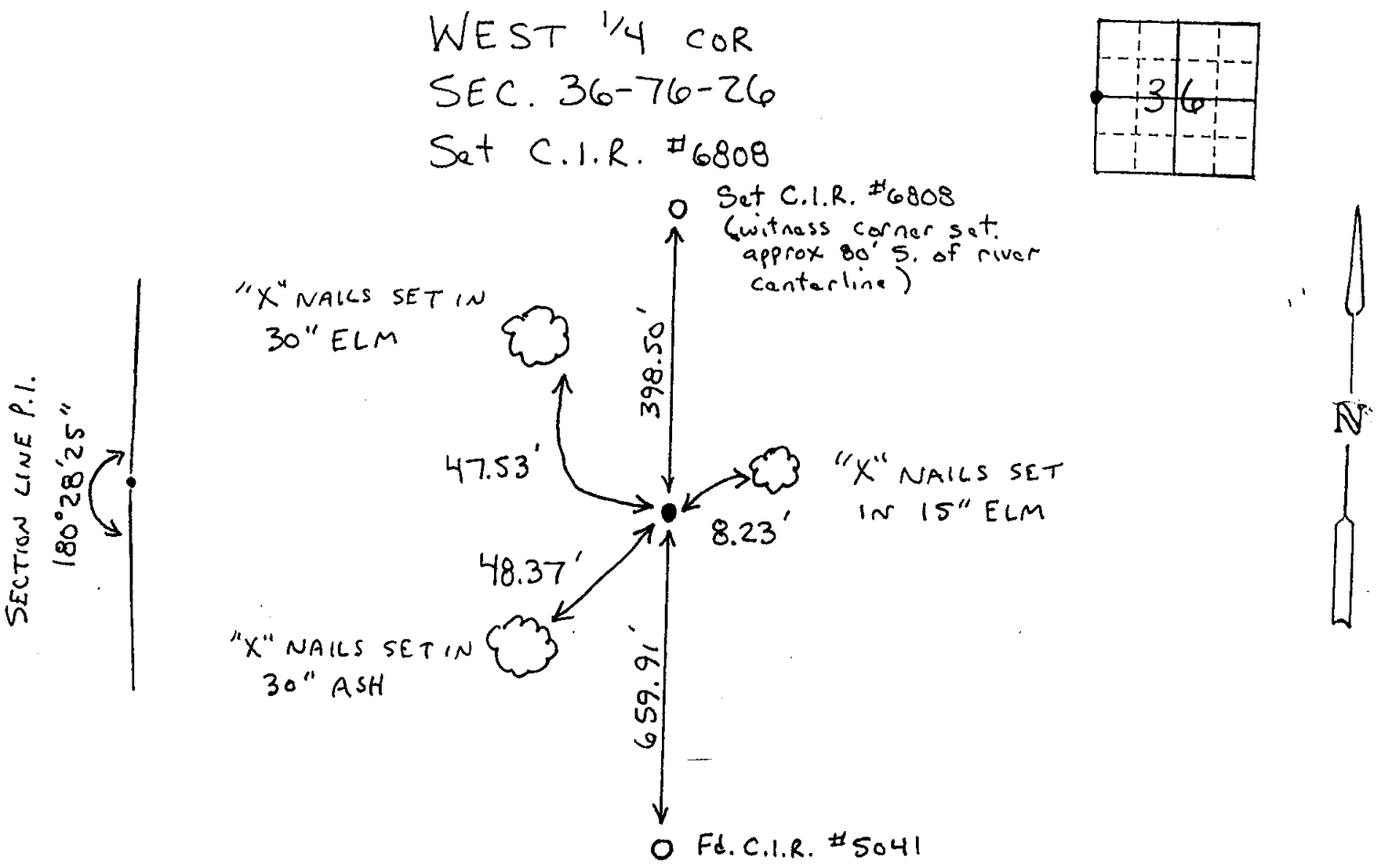

LICENSED LAND SURVEYOR
J. M. HOCHSTETLER
6808
IOWA

I hereby certify that this land surveying document was prepared and the related survey work was performed by me or under my direct personal supervision and that I am a duly licensed Land Surveyor under the laws of the State of Iowa.

J.M. Hochstetler

J.M. HOCHSTETLER
License number 6808 Date 4/19/02.
My license renewal date is December 31, 2003
Pages or sheets covered by this seal: 1

List Corners to be Indexed

Corners	Section	Twp	Range
W. 1/4 cor.	36	76N	26W