003110

FILED NO.

BOOK 2002 PAGE 3110

2002 JUN 26 AM 8:13

MICKI UTSLER
RECORDER
MADISON COUNTY, IOWA

REC $ 5.00
AUD $
R.M.F. $ 1.00

COMPUTER ✓
RECORDED ✓
COMPARED

J

VANCE & HOCHSTETLER, P.C., CONSULTING ENGINEERS, WINTERSET, IOWA (515) 462-3995
CHARLES T. VANCE, 110 West Green St., Winterset, Iowa, 50273
JAMES M HOCHSTETLER, 110 West Green St., Winterset, Iowa 50273

UNITED STATES PUBLIC LAND SURVEY CORNER CERTIFICATE

OF


Land Survey Monuments situated in Section 20, Township 77 N., Range 27 W., of the Fifth Principal Meridian, MADISON County, Iowa.
Previously recorded in _____ in County Recorder's Office.
(book, page, document number, etc.)

(Show reason for preparing this certificate, the evidence and detailed procedures used in establishing the the corner positions and monumentation found or placed.)

Monument Description and Remarks: ① N.W. COR NE¼ NW¼ - Set yellow CIR #6808 4" Deep Set on line between found N¼ Corner and NW corner in line with property line fence South. ② SW Cor NE¼ NW¼ - Set yellow CIR #6808 at old established property line fence Corner. ③ SE. Cor NE¼ NW¼ - Set yellow CIR #6808 at old established property line fence Corner. ④ Center - Set yellow CIR #6808 at old established property line fence corner.

PLAN - VIEW

(Show a minimum of three reference ties to durable physical objects, relevant monuments and physical conditions that will enable recovery of the corner.)

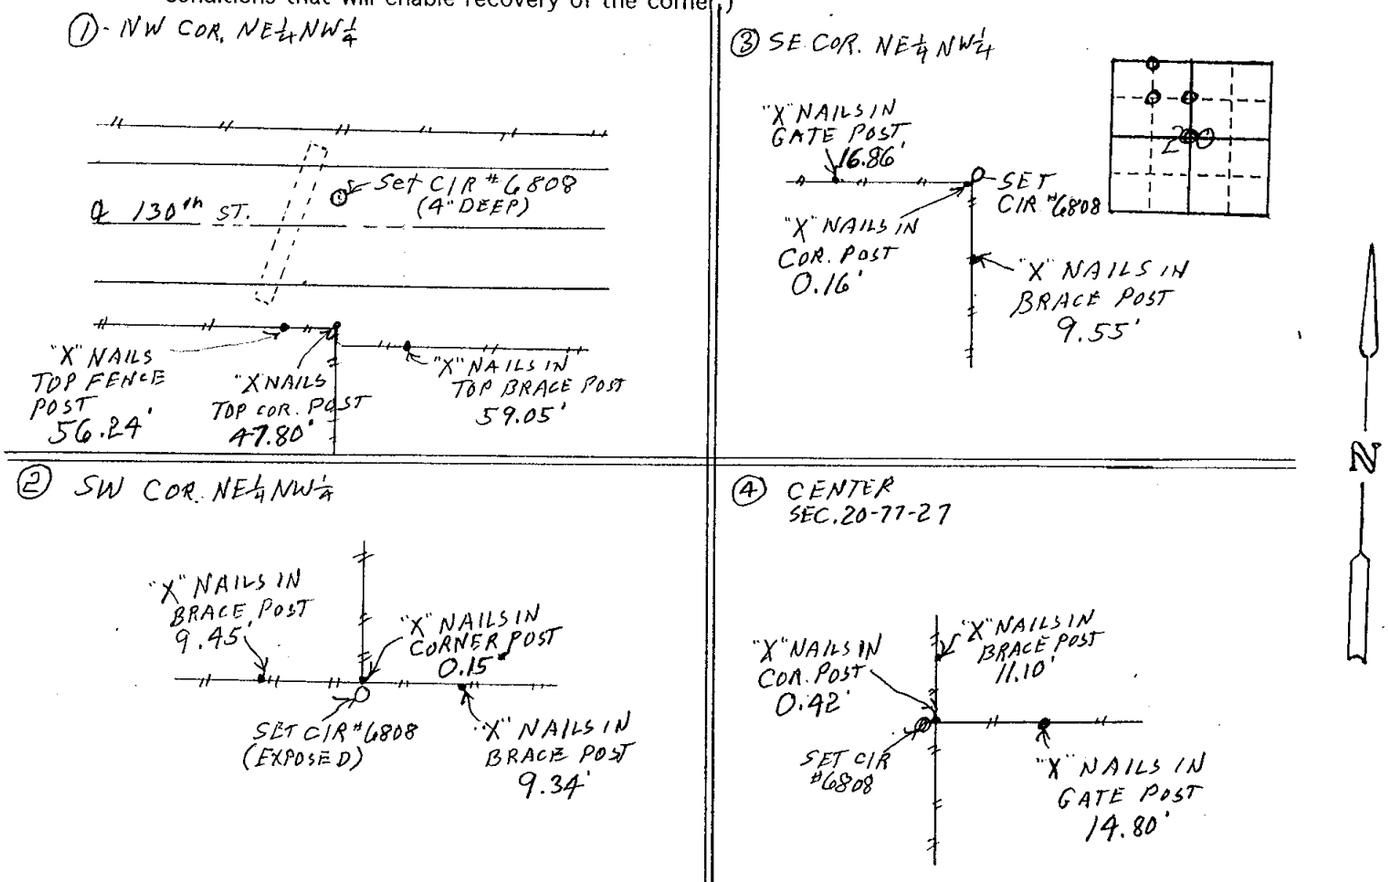

LICENSED LAND SURVEYOR
J. M. HOCHSTETLER
6808
IOWA

I hereby certify that this land surveying document was prepared and the related survey work was performed by me or under my direct personal supervision and that I am a duly licensed Land Surveyor under the laws of the State of Iowa.

J.M. Hochstetler

J.M. HOCHSTETLER
License number 6808 Date 6/19/02.
My license renewal date is December 31, 2003
Pages or sheets covered by this seal: 1

List Corners to be Indexed

Corners	Section	Twp	Range
NW COR NE¼ NW¼	20	77N	27W
SW COR NE¼ NW¼	20	77N	27W
SE COR. NE¼ NW¼	20	77N	27W
CENTER	20	77N	27W