REC $ 5.00
AUD $
R.M.F. $ 1.00

COMPUTER ✓✓
RECORDED ✓
COMPARED ✓

FILED NO. 003250
BOOK 2002 PAGE 3250

2002 JUL -2 PM 4:03

MICK LUTSLER
RECORDER
MADISON COUNTY, IOWA

VANCE & HOCHSTETLER, P.C., CONSULTING ENGINEERS, WINTERSET, IOWA (515) 462-3895
CHARLES T. VANCE, 110 West Green St., Winterset, Iowa, 50273
JAMES M HOCHSTETLER, 110 West Green St., Winterset, Iowa 50273

UNITED STATES PUBLIC LAND SURVEY CORNER CERTIFICATE

OF


Land Survey Monuments situated in Section 17, Township 74 N, Range 27 W, of the Fifth Principal Meridian, MADISON County, Iowa.
Previously recorded in _____ in County Recorder's Office.
(book, page, document number, etc.)

(Show reason for preparing this certificate, the evidence and detailed procedures used in establishing the the corner positions and monumentation found or placed.)

Monument Description and Remarks: N¼ Cor. - Set yellow CIR. #6808 at intersection of property line fence from South and on line between found NE Cor of Section and ℄ County Road near NW Cor. of Section.
NW Cor NE¼ NW¼ - Set yellow CIR #6808 at intersection of property line fence from South and line between set N¼ Cor. and ℄ County Road near NW Cor. of Section
SE Cor NE¼ NW¼ - Set yellow CIR #6808 at intersection property line fences N, S. & W.
S.W. Cor. NE¼ NW¼ - Set yellow CIR #6808 at 4-Way property line fence intersection

PLAN - VIEW

(Show a minimum of three reference ties to durable physical objects, relevant monuments and physical conditions that will enable recovery of the corner.)

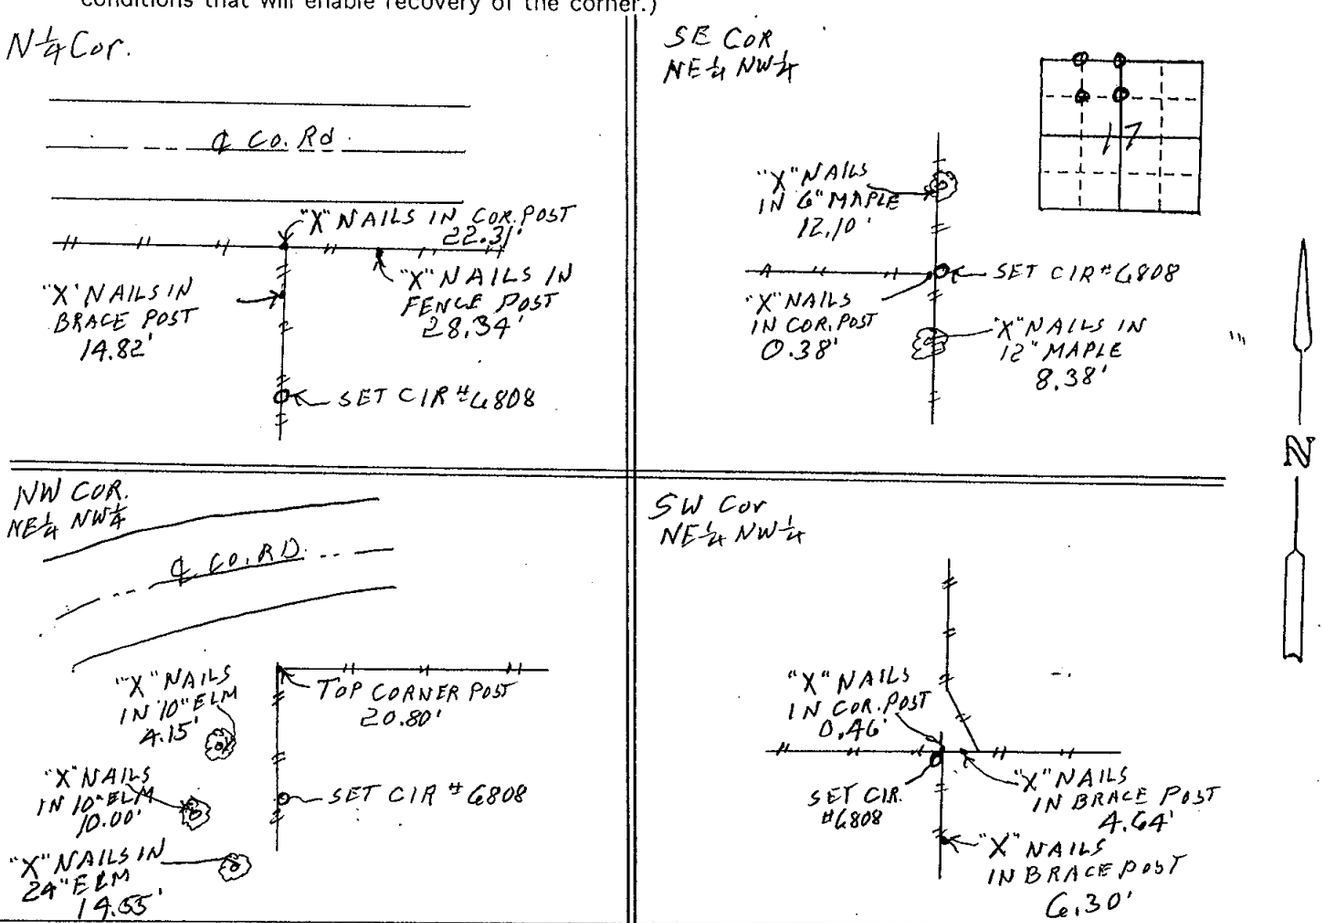

LICENSED LAND SURVEYOR
J. M. HOCHSTETLER
6808
IOWA

I hereby certify that this land surveying document was prepared and the related survey work was performed by me or under my direct personal supervision and that I am a duly licensed Land Surveyor under the laws of the State of Iowa.

J.M. HOCHSTETLER
License number 6808 Date 6/28/02.
My license renewal date is December 31, 2003
Pages or sheets covered by this seal: 1

List Corners to be Indexed

Corners	Section	Twp	Range
N¼ Cor.	17	74N	27W
NW COR NE¼ NW¼	17	74N	27W
SE COR NE¼ NW¼	17	74N	27W
SW COR. NE¼ NW¼	17	74N	27W