FILED NO. 003956

BOOK 2002 PAGE 3956

REC $ 5.00
AUD $ ____
R.M.F. $ 1.00

COMPUTER ✓
RECORDED ✓
COMPARED ____

2002 AUG 13 PM 2:59

MICKI UTSLER
RECORDER
MADISON COUNTY, IOWA

J

Prepared By: J. Brian Morrissey, Morrissey Surveying, 1405 Hwy. G28, Otley, IA 50214, Tel. (641) 627-5554

UNITED STATES PUBLIC LAND SURVEY CORNER CERTIFICATE OF

Land Survey Monuments situated in Section 27, Township 74 N, Range 26 W, of the Fifth Principal Meridian, Madison County, Iowa.
Previously recorded in N.A. in County Recorders Office.


(book, page, document number,etc.)


(Show reason for preparing this certificate, the evidence and detailed procedures used in establishing the corner positions and monumentation found or placed.)

Monument Description and Remarks: Set 5/8" rebar with orange plastic cap, P.L.S. #7995, at the midpoint between E. Qtr. Cor. and the calculated SW. cor. of the NE. 1/4. Calculated SW. cor. of the NE. 1/4 based on traversing Sec. 27.

PLAN VIEW

(Show a minimum of three reference ties to durable physical objects, relevant monuments and physical conditions that will enable recovery of the corner.)

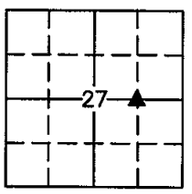

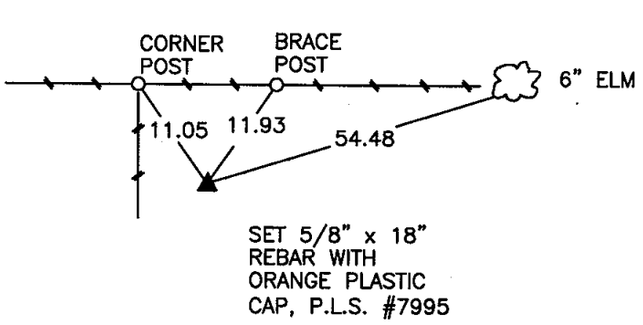



SW. COR., SE. 1/4., NE. 1/4, SEC. 27

NOTE: ALL TIES TO "X" NAILS UNLESS NOTED.



I hereby certify that the survey work was completed and this certificate was prepared by me or under my direct personal supervision and that I am a duly Licensed Land Surveyor under the laws of the State of Iowa.

Signature: J. Brian Morrissey Date: 8/12/02

J. Brian Morrissey

License number 7995.
My license renewal date is December 31, 2003.

381-02-03