

003350

FILED NO. _____

BOOK 2002 PAGE 3350

2002 JUL 10 AM 11:41


MICKI UTSLER
RECORDER
MADISON COUNTY, IOWA

REC \$ 5⁰⁰
AUD \$ _____
R.M.F. \$ 1⁰⁰

COMPUTER
RECORDED
COMPARED _____


VANCE & HOCHSTETLER, P.C. CONSULTING ENGINEERS, WINTERSET, IOWA (515) 462-3995
CHARLES T. VANCE, 110 WEST GREEN ST., WINTERSET, IOWA 50273
JAMES M HOCHSTETLER, 110 WEST GREEN ST., WINTERSET, IOWA 50273

PLAT OF SURVEY OF THE WEST HALF OF THE NORTHWEST QUARTER OF
THE SOUTHEAST QUARTER OF SECTION 18, TOWNSHIP 75 NORTH, RANGE
26 WEST OF THE 5TH P.M., MADISON COUNTY, IOWA, OWNED BY JOSEPH A.
BORGEN AND DEBORAH I BORGEN.

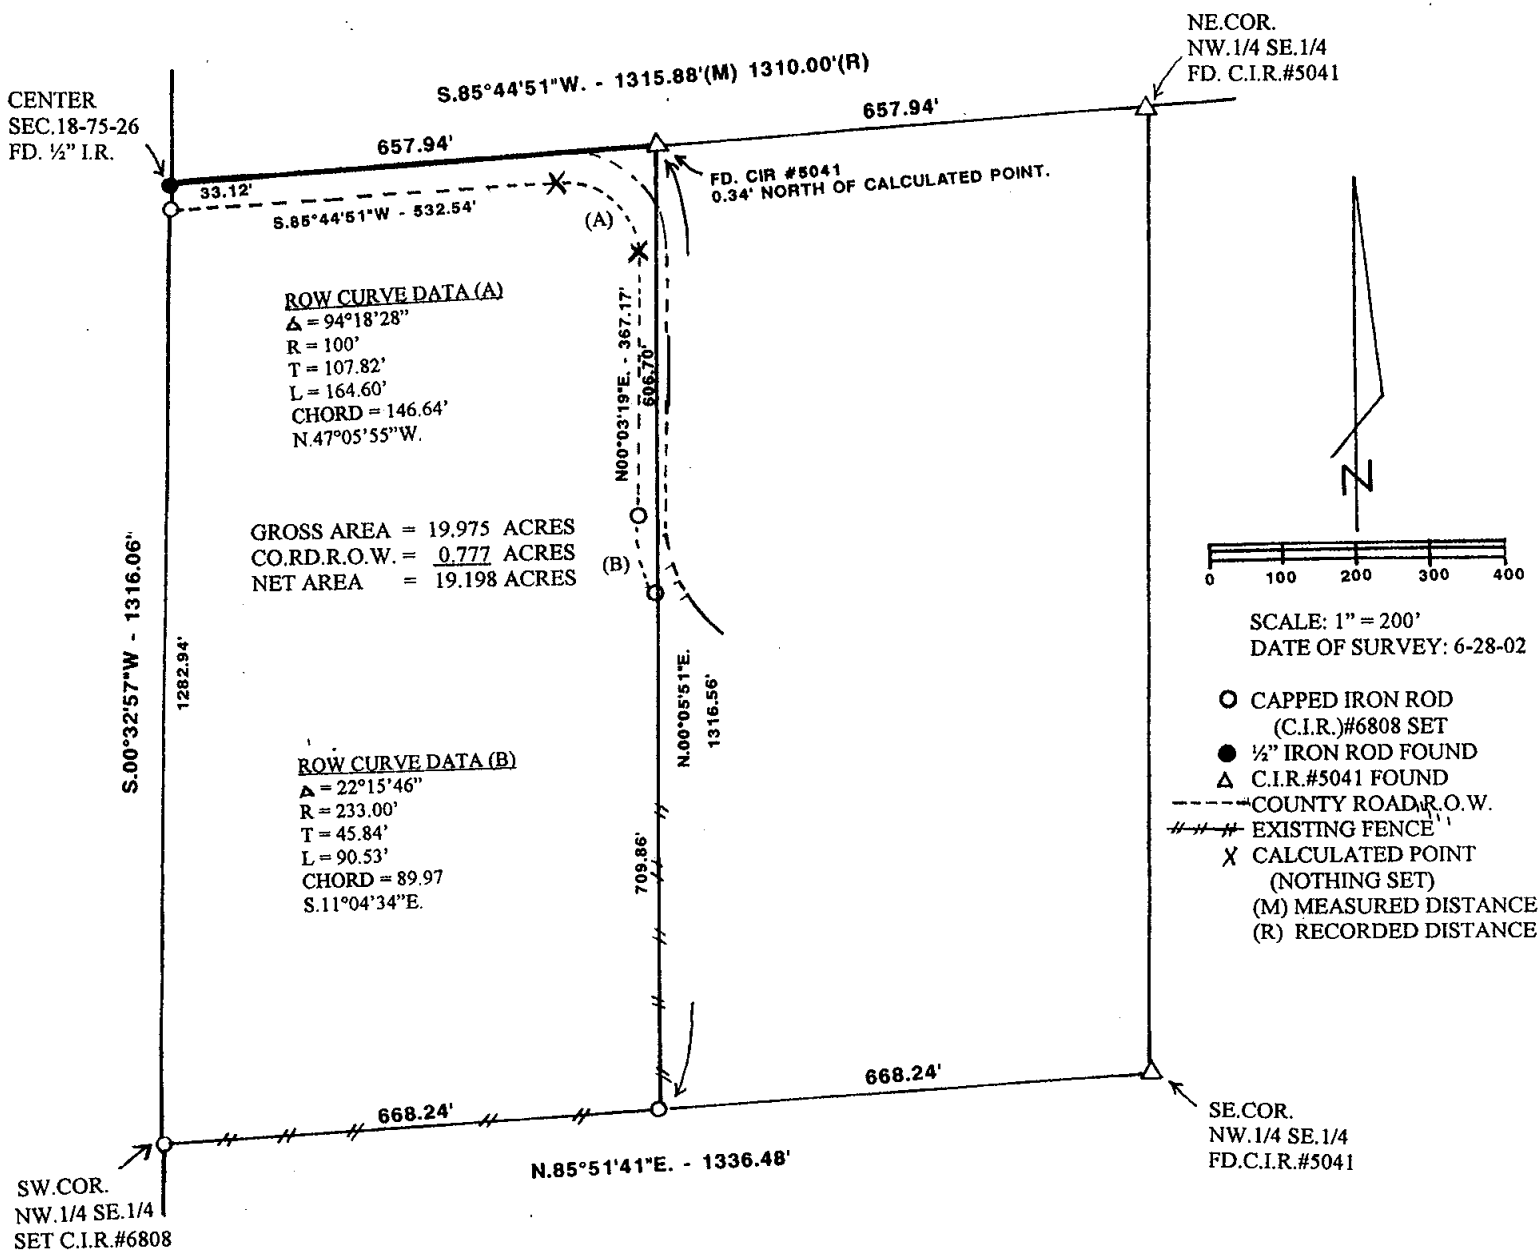

LEGAL DESCRIPTION:

THE WEST HALF OF THE NORTHWEST QUARTER OF THE SOUTHEAST QUARTER OF SECTION 18, TOWNSHIP 75 NORTH, RANGE 26 WEST OF THE 5TH P.M., MADISON COUNTY, IOWA CONTAINING 19.975 ACRES INCLUDING 0.777 ACRES OF COUNTY ROAD RIGHT-OF-WAY.

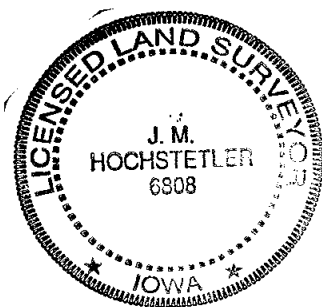

I hereby certify that this land surveying document was prepared and the related survey work was performed by me or under my direct personal supervision and that I am a duly licensed Land Surveyor under the laws of the State of Iowa.

J.M. Hochstetler
 J.M. HOCHSTETLER
 License number 6808 Date 7/10/02
 My license renewal date is December 31, 2003
 Pages or sheets covered by this seal: 1