

REC \$ 5⁰⁰
AUD \$
R.M.F. \$ 1⁰⁰

COMPUTER
INDEXED
COMPARED

NICKI UTSLER
RECORDER
MADISON COUNTY, IOWA

Nortline Franklin Norton 425 9th Street • Carlsle, IA 50047 • (515) 989-3677

Surveyors

UNITED STATES PUBLIC LAND SURVEY CORNER CERTIFICATE
OF


Land Survey Monuments situated in Section 17, Township 27, Range 26 west, of the Fifth Principal Meridian, MADISON County, Iowa.
Previously recorded in N/A in County Recorder's Office.

(book, page, document number, etc.)
(Show reason for preparing this certificate, the evidence and detailed procedures used in establishing the corner positions and monumentation found or placed.)

Monument Description and Remarks: Found 20H Nail

PLAN - VIEW

(Show a minimum of three reference ties to durable physical objects, relevant monuments and physical conditions that will enable recovery of the corner.)

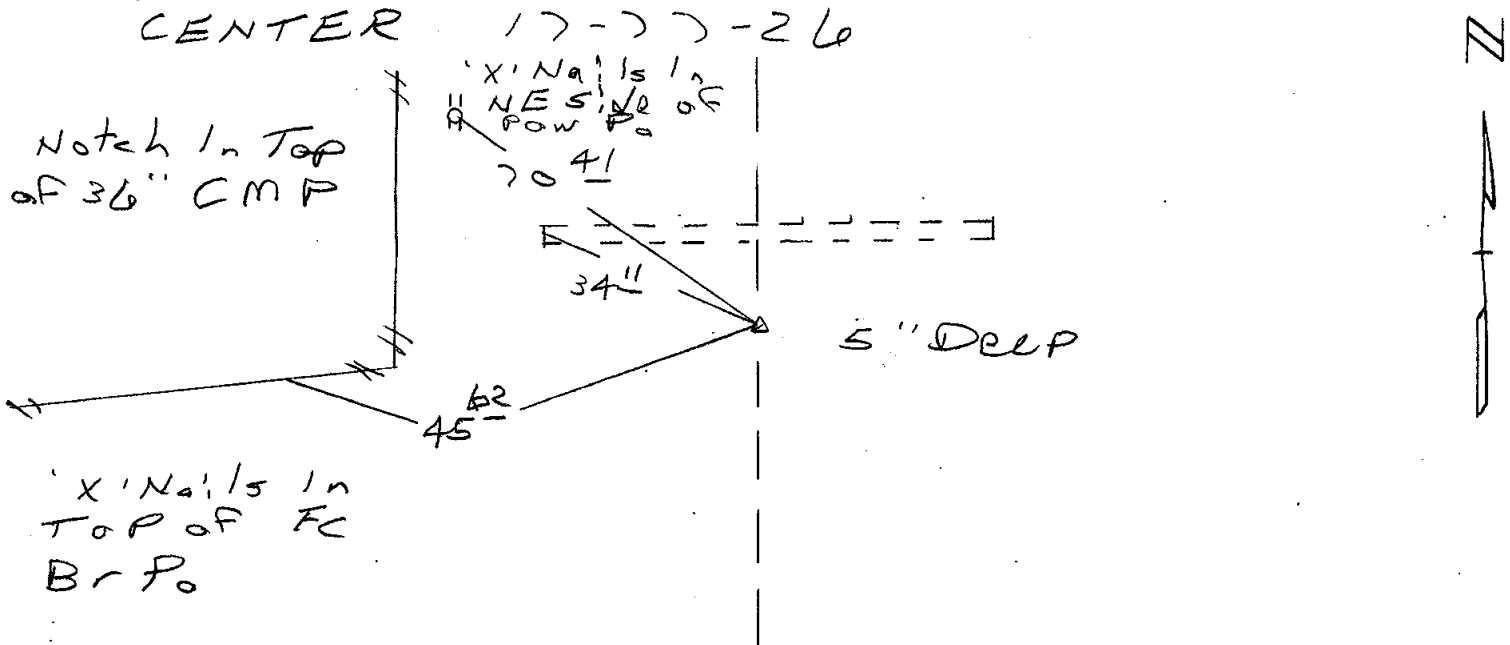

Set 1/2\"/>

I hereby certify that the survey work was completed and this land surveying document was prepared by me or under my direct personal supervision and that I am a duly licensed Land Surveyor under the laws of the state of Iowa.

Signature: Franklin A. Norton
Name typed or printed: FRANKLIN A. NORTON

Date: 6-15-02 Lisc. No. 5301

My license renewal date is December 31, 2002

Corners	Section	Twp	Range
CENTER	17	27	26

