FILED NO. 004586
BOOK 2002 PAGE 4586
2002 SEP 17 PM 12: 18
MICKI UTSLER
RECORDER
MADISON COUNTY, IOWA

REC $ 5.00
AUD $
R.M.F. $ 1.00

COMPUTER ✓
RECORDED ✓
COMPARED

VANCE & HOCHSTETLER, P.C., CONSULTING ENGINEERS, WINTERSET, IOWA (515) 462-3995
CHARLES T. VANCE, 110 West Green St., Winterset, Iowa, 50273
JAMES M HOCHSTETLER, 110 West Green St., Winterset, Iowa 50273

UNITED STATES PUBLIC LAND SURVEY CORNER CERTIFICATE

OF


Land Survey Monuments situated in Section 30, Township 76 N, Range 28W, of the Fifth Principal Meridian, MADISON County, Iowa.
Previously recorded in _____ in County Recorder's Office.
(book, page, document number, etc.)


(Show reason for preparing this certificate, the evidence and detailed procedures used in establishing the the corner positions and monumentation found or placed.)

Monument Description and Remarks: SE COR NWFr¼ NW¼ - Set yellow C.I.R. #6808 in field at intersection of line between N.E. Cor. NWFr¼ NW¼ & SE Cor SWFr¼ NW¼ and line between SE Cor NE¼ NW¼ & SW Cor. NWFr¼ NW¼. SE Cor. SWFr¼ NW¼ - Set yellow C.I.R. #6808 in field at intersection of line from center to W¼ Corner and projection of existing property line fence along the East line of WFr½ of SW¼.

PLAN - VIEW

(Show a minimum of three reference ties to durable physical objects, relevant monuments and physical conditions that will enable recovery of the corner.)

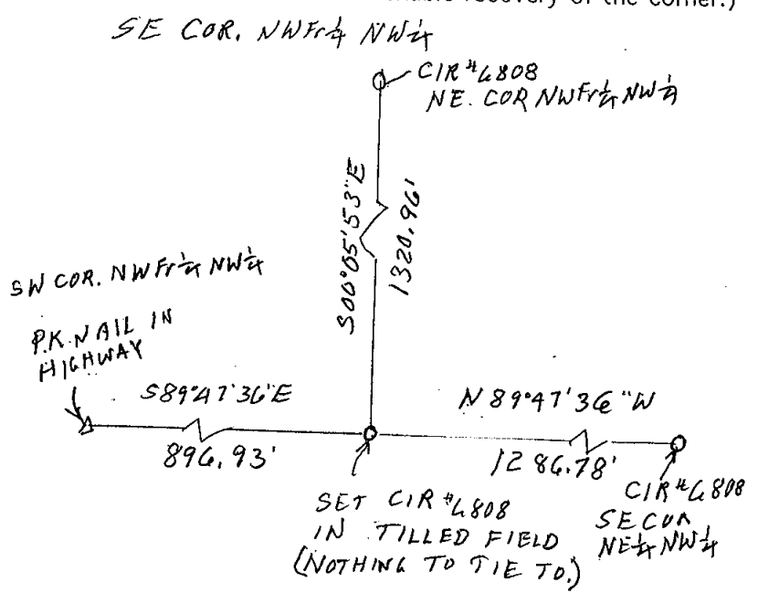

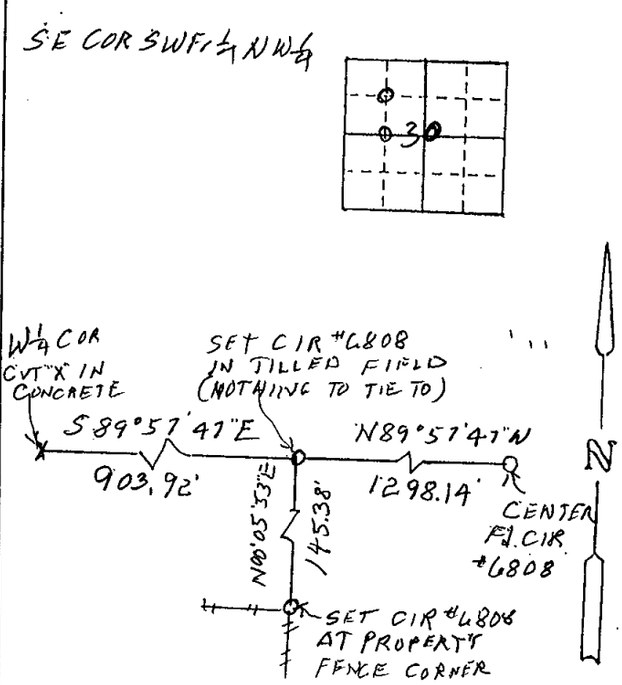

LICENSED LAND SURVEYOR
J.M. HOCHSTETLER
6808
IOWA

I hereby certify that this land surveying document was prepared and the related survey work was performed by me or under my direct personal supervision and that I am a duly licensed Land Surveyor under the laws of the State of Iowa.

J.M. HOCHSTETLER
License number 6808 Date 8/30/02.
My license renewal date is December 31 2003
Pages or sheets covered by this seal: 1

List Corners to be Indexed

Corners	Section	Twp	Range
SE COR NWFr¼ NW¼	30	76 N	28W
SE COR SWFr¼ NW¼	30	76N	28W