FILED NO. 004593

REC $ 5.00
AUD $ ____
R.M.F. $ 1.00

COMPUTER ✓
RECORDED ✓
COMPARED ____

BOOK 2002 PAGE 4593

2002 SEP 17 PM 12:27

NICKI UTSLER
RECORDER
MADISON COUNTY, IOWA

VANCE & HOCHSTETLER, P.C., CONSULTING ENGINEERS, WINTERSET, IOWA (515) 462-3995
02-1645 CHARLES T. VANCE, 110 West Green St., Winterset, Iowa, 50273
JAMES M HOCHSTETLER, 110 West Green St., Winterset, Iowa 50273

UNITED STATES PUBLIC LAND SURVEY CORNER CERTIFICATE

OF


Land Survey Monuments situated in Section 14, Township 76 N, Range 29W, of the Fifth Principal Meridian, MADISON County, Iowa.
Previously recorded in _____ in County Recorder's Office.
(book, page, document number, etc.)

(Show reason for preparing this certificate, the evidence and detailed procedures used in establishing the the corner positions and monumentation found or placed.)

Monument Description and Remarks: SW Cor. NE¼ NE¼ - Set yellow CIR #6808 exposed at midpoint and on line between set NW Cor NE¼ NE¼ and property line fence corner at SW Cor SE¼ NE¼.
S.E. Cor. NE¼ NE¼ - Set yellow CIR #6808 exposed on projected line from West Quarter Corner Through property line fence corner at SW Cor. SE¼ NE¼ and at distance equal to ⅓ of distance from W¼ Cor to SW Cor SE¼ NE¼.

PLAN - VIEW

(Show a minimum of three reference ties to durable physical objects, relevant monuments and physical conditions that will enable recovery of the corner.)

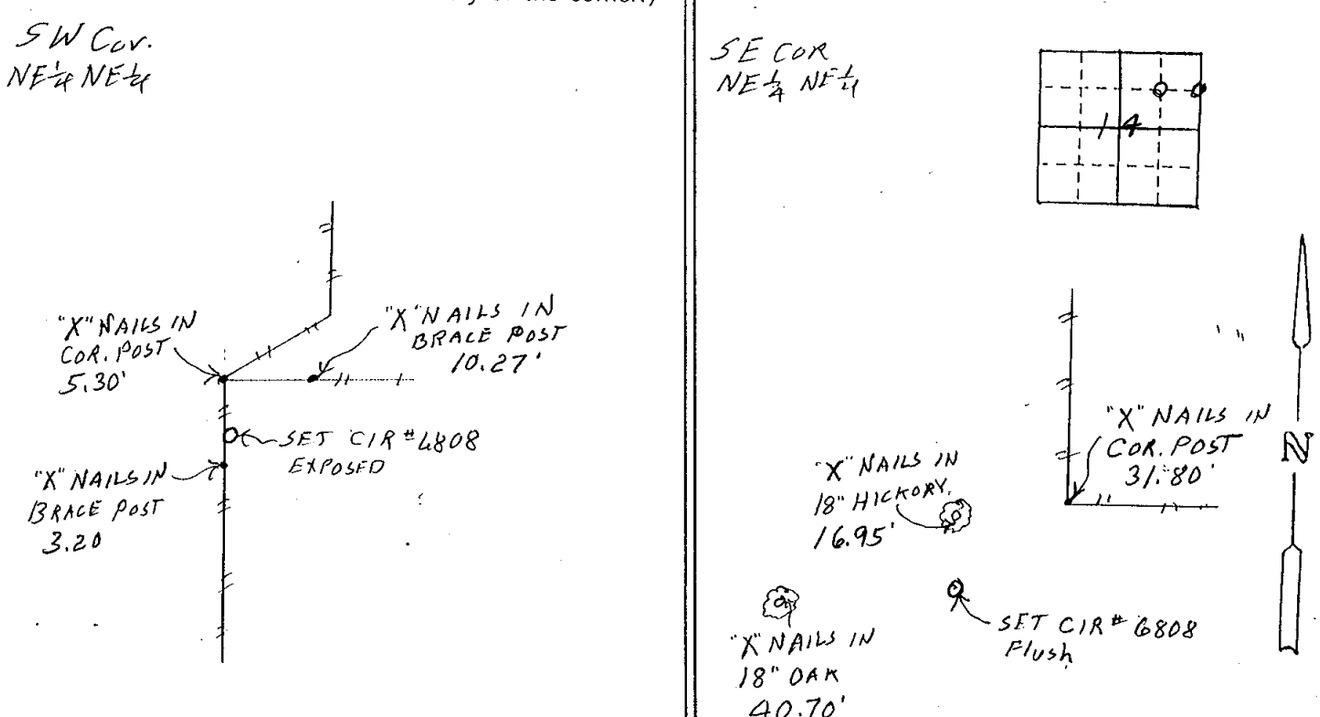

LICENSED LAND SURVEYOR
J. M. HOCHSTETLER
6808
IOWA

I hereby certify that this land surveying document was prepared and the related survey work was performed by me or under my direct personal supervision and that I am a duly licensed Land Surveyor under the laws of the State of Iowa.

J.M. HOCHSTETLER
License number 6808 Date 8/23/02
My license renewal date is December 31, 2003
Pages or sheets covered by this seal: 1

List Corners to be Indexed

Corners	Section	Twp	Range
SW COR NE¼ NE¼	14	76N	29W
SE COR NE¼ NE¼	14	76N	29W