REC $ 5.00
AUD $
R.M.F. $ 1.00

FILED NO. 004190
BOOK 2002 PAGE 4190
2002 AUG 27 AM 10: 06
MICKI UTSLER
RECORDER
MADISON COUNTY, IOWA

COMPUTER ✓
RECORDED ✓
COMPARED

VANCE & HOCHSTETLER, P.C., CONSULTING ENGINEERS, WINTERSET, IOWA (515) 462-3995
02-1215 CHARLES T. VANCE, 110 West Green St., Winterset, Iowa, 50273
JAMES M HOCHSTETLER, 110 West Green St., Winterset, Iowa 50273

UNITED STATES PUBLIC LAND SURVEY CORNER CERTIFICATE

OF

Land Survey Monuments situated in Section 7, Township 75 NORTH, Range 26 WEST, of the Fifth Principal Meridian, MADISON County, Iowa.
Previously recorded in N/A (book, page, document number, etc.) in County Recorder's Office.

(Show reason for preparing this certificate, the evidence and detailed procedures used in establishing the the corner positions and monumentation found or placed.)


Monument Description and Remarks: NE COR S½ SW fr ¼ - Found ⅝" IRON ROD 4" DEEP in line with property line fences East and West.

NW Cor S½ SW fr ¼ - Set yellow CIR #6808 at 3 Way property line fence corner.

SW Cor - Found PK Nail 0.40 Set South of ℄ of County Road. Nail noted as set by Co. Engr. Crew.

PLAN - VIEW

(Show a minimum of three reference ties to durable physical objects, relevant monuments and physical conditions that will enable recovery of the corner.)

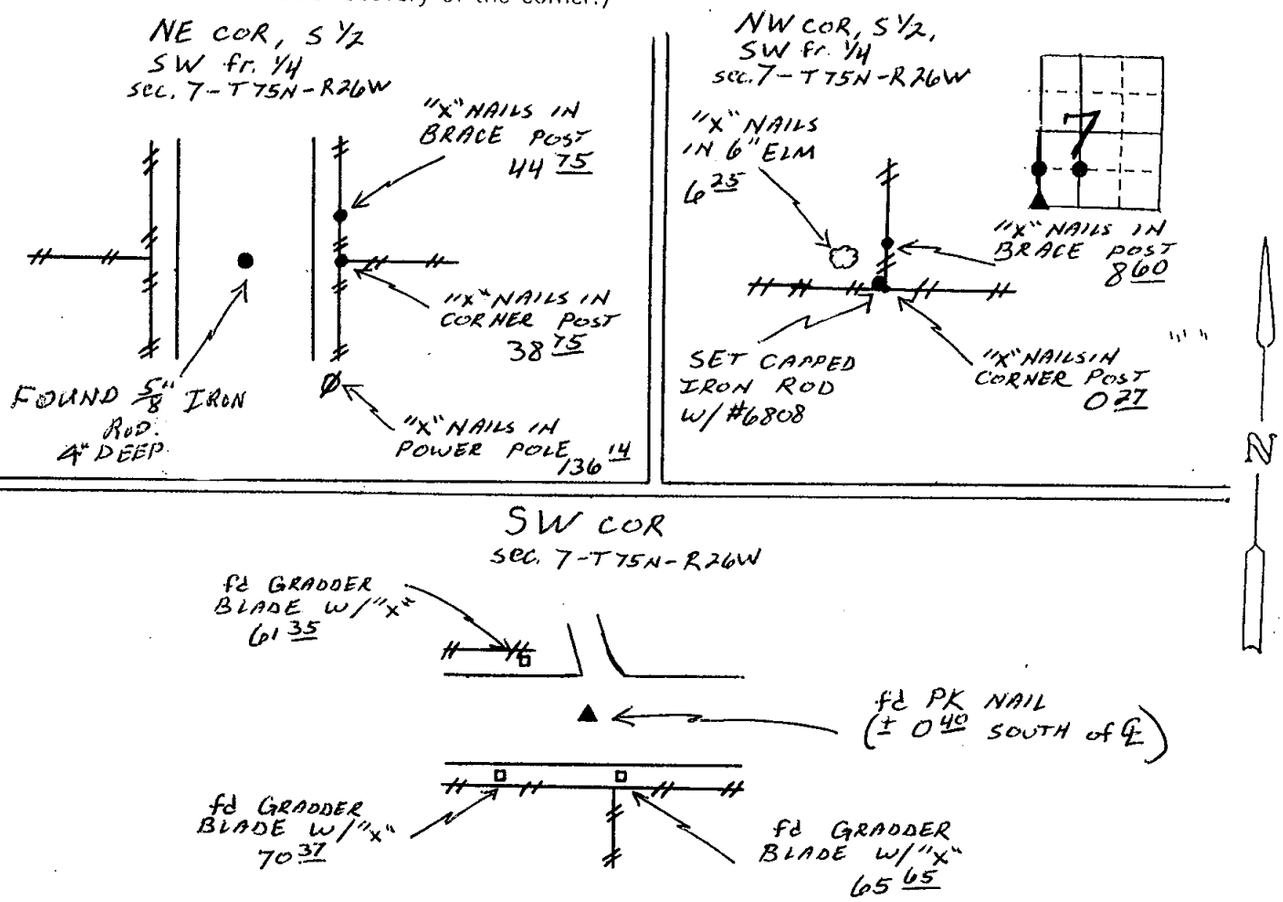

LICENSED LAND SURVEYOR
J. M. HOCHSTETLER
6808
IOWA

I hereby certify that this land surveying document was prepared and the related survey work was performed by me or under my direct personal supervision and that I am a duly licensed Land Surveyor under the laws of the State of Iowa.

J.M. HOCHSTETLER
License number 6808 Date 7/19/02
My license renewal date is December 31, 2003
Pages or sheets covered by this seal: 1

List Corners to be Indexed

Corners	Section	Twp	Range
NE COR, S½, SW fr ¼	7	75	26
NW COR S½, SW fr ¼	7	75	26
SW COR	7	75	26