REC $ 5.00
AUD $
R.M.F. $ 1.00

COMPUTER ✓✓
RECORDED ✓
COMPARED

FILED NO. 004578
BOOK 2002 PAGE 4578
2002 SEP 17 PM 12: 10

MICKI UTSLER
RECORDER
MADISON COUNTY, IOWA

VANCE & HOCHSTETLER, P.C., CONSULTING ENGINEERS, WINTERSET, IOWA (515) 462-3995
02-1925 CHARLES T. VANCE, 110 West Green St., Winterset, Iowa, 50273
JAMES M HOCHSTETLER, 110 West Green St., Winterset, Iowa 50273

UNITED STATES PUBLIC LAND SURVEY CORNER CERTIFICATE

OF

Land Survey Monuments situated in Section 18, Township 75 N, Range 26 W., of the Fifth Principal Meridian, MADISON County, Iowa.
Previously recorded in _____ in County Recorder's Office.
(book, page, document number, etc.)

(Show reason for preparing this certificate, the evidence and detailed procedures used in establishing the the corner positions and monumentation found or placed.)


Monument Description and Remarks: SW COR. N½ NWFr¼ - Set yellow C.I.R. # 6808 at mid point on line between found NW Cor and calculated W¼ Cor. Used original survey notes and prorated distances of North line of NWFr¼ and South line of SWFr¼ to calculate W¼ Cor. - Point is in middle of cultivated field.

SE Cor. N½ NWFr¼ - Set yellow CIR # 6808 at midpoint between found N¼ Cor and Center.


PLAN - VIEW


(Show a minimum of three reference ties to durable physical objects, relevant monuments and physical conditions that will enable recovery of the corner.)

SW COR
N½ NWFr¼

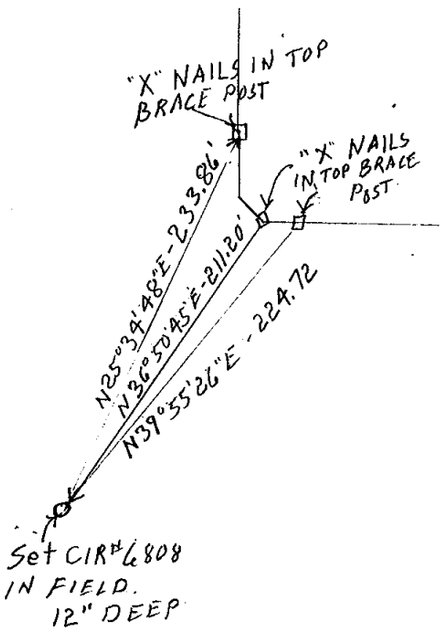

SE COR
N½ NWFr¼

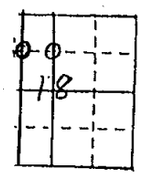

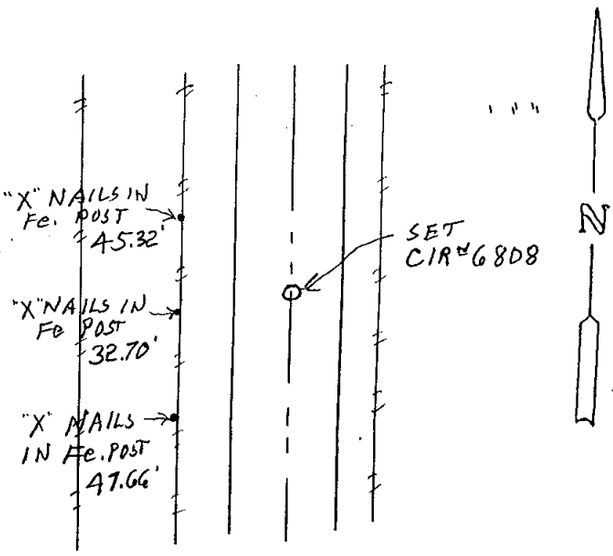

LICENSED LAND SURVEYOR
J. M. HOCHSTETLER
6808
IOWA

I hereby certify that this land surveying document was prepared and the related survey work was performed by me or under my direct personal supervision and that I am a duly licensed Land Surveyor under the laws of the State of Iowa.

J.M. HOCHSTETLER
License number 6808 Date 8/30/02
My license renewal date is December 31, 2003
Pages or sheets covered by this seal: 1

List Corners to be Indexed

Corners	Section	Twp	Range
SW COR N½ NWFr¼	18	75N	26W
S.E. COR N½ NWFr¼	18	75N	26W