REC $ 5.00
AUD $
R.M.F. $ 1.00

FILED NO. 006076
BOOK 2002 PAGE 6076
2002 DEC 13 PM 2:40
MICKI UTSLER
RECORDER
MADISON COUNTY, IOWA

COMPUTER ✓
RECORDED ✓
COMPARED

VANCE & HOCHSTETLER, P.C., CONSULTING ENGINEERS, WINTERSET, IOWA (515) 462-3995
02-2395 CHARLES T. VANCE, 110 West Green St., Winterset, Iowa, 50273
JAMES M HOCHSTETLER, 110 West Green St., Winterset, Iowa 50273

UNITED STATES PUBLIC LAND SURVEY CORNER CERTIFICATE OF

Land Survey Monuments situated in Section 33, Township 76N, Range 27W, of the Fifth Principal Meridian, MADISON County, Iowa.
Previously recorded in _____ (book, page, document number, etc.) in County Recorder's Office.

(Show reason for preparing this certificate, the evidence and detailed procedures used in establishing the the corner positions and monumentation found or placed.)

Monument Description and Remarks: SE COR. SW¼ NE¼ - Set yellow CIR #6808 at mid point on line between found Center and E¼ Corner of Section 33.


W¼ Corner - Found ½" Pipe at steel fence post as shown on records at Co. Engineer's Office as tied by Barry Bishop.


PLAN - VIEW


(Show a minimum of three reference ties to durable physical objects, relevant monuments and physical conditions that will enable recovery of the corner.)

SE COR
SW¼ NE¼
SEC. 33-76-27

W¼ COR
SEC. 33-76-27

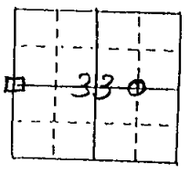

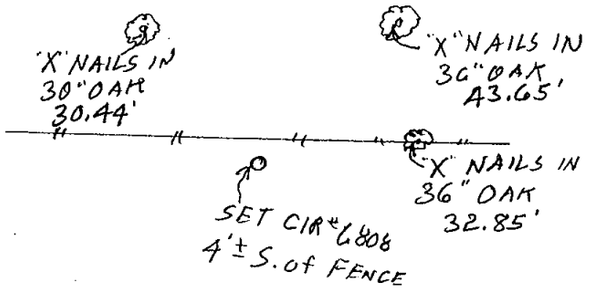

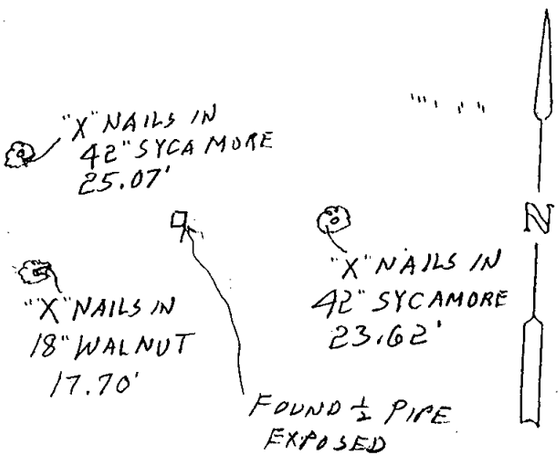

LICENSED LAND SURVEYOR
J. M. HOCHSTETLER
6808
IOWA

I hereby certify that this land surveying document was prepared and the related survey work was performed by me or under my direct personal supervision and that I am a duly licensed Land Surveyor under the laws of the State of Iowa.

J.M. HOCHSTETLER
License number 6808 Date 12/6/02.
My license renewal date is December 31 2003
Pages or sheets covered by this seal: 1

List Corners to be Indexed

Corners	Section	Twp	Range
SE COR SW¼ NE¼	33	76N	27W
W¼ Cor.	33	76N	27W