REC $ 5.00
AUD $ .00
R.M.F. $ 1.00

FILED NO. 005560
BOOK 2002 PAGE 5560
2002 NOV 13 AM 11:08
MICKI UTSLER
RECORDER
MADISON COUNTY, IOWA

COMPUTER ✓
RECORDED
COMPARED

VANCE & HOCHSTETLER, P.C., CONSULTING ENGINEERS, WINTERSET, IOWA (515) 462-3995
CHARLES T. VANCE, 110 West Green St., Winterset, Iowa, 50273
JAMES M HOCHSTETLER, 110 West Green St., Winterset, Iowa 50273

UNITED STATES PUBLIC LAND SURVEY CORNER CERTIFICATE

OF


Land Survey Monuments situated in Section 8, Township 75 N, Range 26 W, of the Fifth Principal Meridian, MADISON County, Iowa.
Previously recorded in _____ in County Recorder's Office.
(book, page, document number, etc.)

(Show reason for preparing this certificate, the evidence and detailed procedures used in establishing the the corner positions and monumentation found or placed.)

Monument Description and Remarks: N.W. COR - Set yellow CIR #6808 at ℄ County Road R.O.W. in line with old property line fence East.
N.E. Cor. NW¼ NW¼ - Set yellow CIR #6808 on line between found N¼ Cor and Set NW Cor at midpoint.

PLAN - VIEW

(Show a minimum of three reference ties to durable physical objects, relevant monuments and physical conditions that will enable recovery of the corner.)

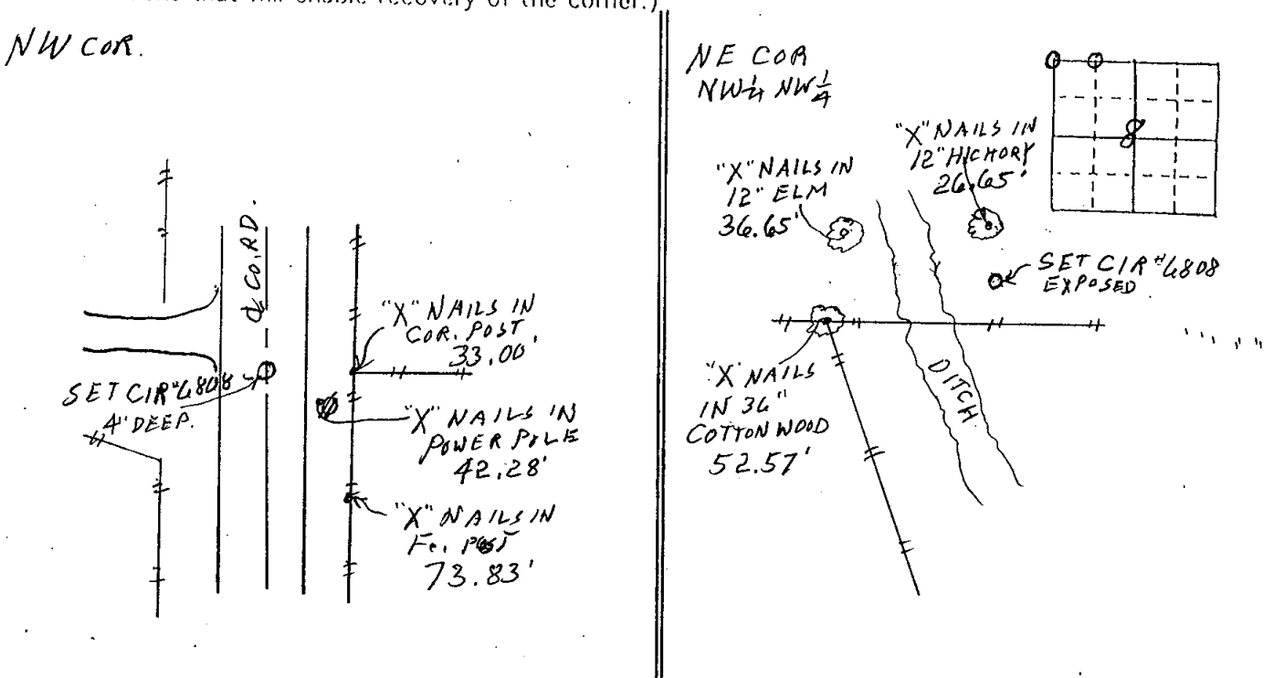

I hereby certify that this land surveying document was prepared and the related survey work was performed by me or under my direct personal supervision and that I am a duly licensed Land Surveyor under the laws of the State of Iowa.

J.M. HOCHSTETLER
License number 6808 Date 10/23/02
My license renewal date is December 31, 2003
Pages or sheets covered by this seal: 1

LICENSED LAND SURVEYOR
J. M. HOCHSTETLER
6808
IOWA

List Corners to be Indexed

Corners	Section	Twp	Range
NW COR	8	75N	26W
NE COR NW¼ NW¼	8	75N	26W