REC $ 5.00
AUD $ ____
R.M.F. $ 1.00

FILED NO. 000046
BOOK 2003 PAGE 46
2003 JAN -3 PM 12:33
MICKI UTSLER
RECORDER
MADISON COUNTY, IOWA

COMPUTER ✓
RECORDED ✓
COMPARED ____

VANCE & HOCHSTETLER, P.C., CONSULTING ENGINEERS, WINTERSET, IOWA (515) 462-3995
02-2575 CHARLES T. VANCE, 110 West Green St., Winterset, Iowa, 50273
JAMES M HOCHSTETLER, 110 West Green St., Winterset, Iowa 50273

UNITED STATES PUBLIC LAND SURVEY CORNER CERTIFICATE OF

Land Survey Monuments situated in Section 1, Township 77 North, Range 27 West, of the Fifth Principal Meridian, MADISON County, Iowa.
Previously recorded in _____ in County Recorder's Office.
(book, page, document number, etc.)

(Show reason for preparing this certificate, the evidence and detailed procedures used in establishing the the corner positions and monumentation found or placed.)

Monument Description and Remarks:


NE cor. NW.1/4 SW.1/4 - Set Capped Iron Rod #6808 (1/2" rebar, 4" deep)

SW cor. NW.1/4 SW.1/4 - Set C.I.R. #6808 (1/2" rebar, exposed) at existing fence corner.


PLAN - VIEW


(Show a minimum of three reference ties to durable physical objects, relevant monuments and physical conditions that will enable recovery of the corner.)

NE CORNER
NW.1/4 SW.1/4
SEC. 1-77-27
Set C.I.R. #6808

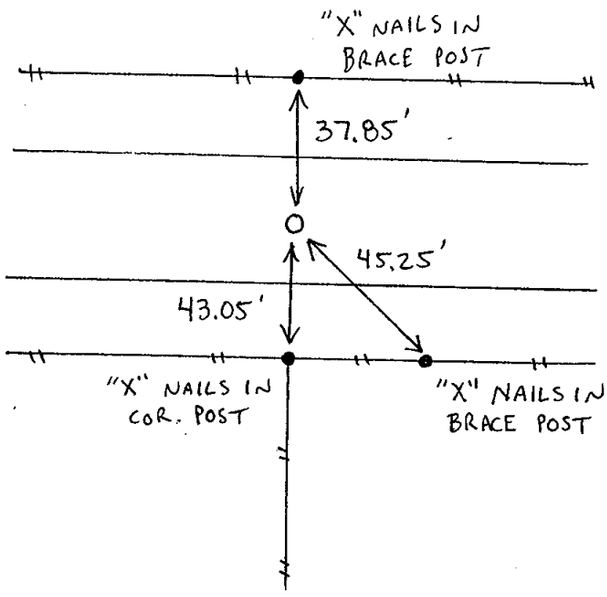

SW CORNER
NW.1/4 SW.1/4
SEC. 1-77-27
Set C.I.R. #6808

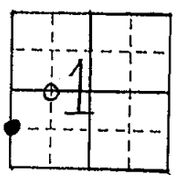

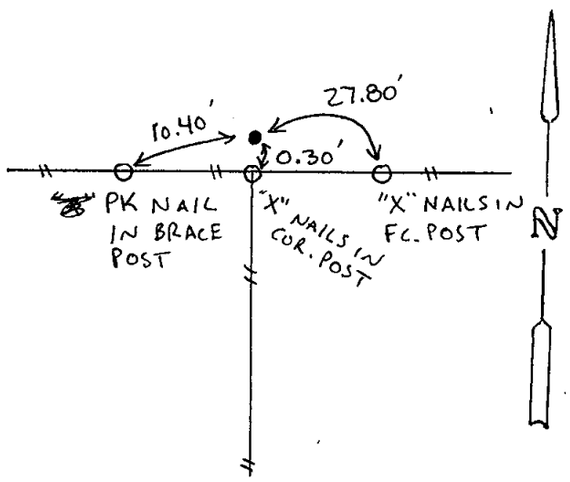



I hereby certify that this land surveying document was prepared and the related survey work was performed by me or under my direct personal supervision and that I am a duly licensed Land Surveyor under the laws of the State of Iowa.

J. M. Hochstetler

J.M. HOCHSTETLER
License number 6808 Date 12/23/02
My license renewal date is December 31, 2003
Pages or sheets covered by this seal: 1

List Corners to be Indexed

Corners	Section	Twp	Range
NE cor. NW.1/4 SW.1/4	1	77N	27W
SW cor. NW.1/4 SW.1/4	1	77N	27W