REC $ 5.00
AUD $
R.M.F. $ 1.00

FILED NO. 000049
BOOK 2003 PAGE 49

2003 JAN -3 PM 12:55

MICKI UTSLER
RECORDER
MADISON COUNTY, IOWA

COMPUTER ✓
RECORDED ✓
COMPARED

✓

VANCE & HOCHSTETLER, P.C., CONSULTING ENGINEERS, WINTERSET, IOWA (515) 462-3995
02-2445 CHARLES T. VANCE, 110 West Green St., Winterset, Iowa, 50273
JAMES M HOCHSTETLER, 110 West Green St., Winterset, Iowa 50273

UNITED STATES PUBLIC LAND SURVEY CORNER CERTIFICATE

OF

Land Survey Monuments situated in Section 21, Township 76 North, Range 26 West, of the Fifth Principal Meridian, MADISON County, Iowa.
Previously recorded in _____ in County Recorder's Office.
(book, page, document number, etc.)

(Show reason for preparing this certificate, the evidence and detailed procedures used in establishing the the corner positions and monumentation found or placed.)


Monument Description and Remarks:

NE cor. NW.1/4 SW.1/4 - Set Capped Iron Rod #6808 (1/2" rebar, 4" deep) at midpoint between W.1/4 cor. and Center (found).
SE cor. NW.1/4 SW.1/4 - Set C.I.R. #6808 (1/2" rebar, 4" deep) at midpoint between the SW cor. NW.1/4 SW.1/4 and the SE cor. NE.1/4 SW.1/4 (both found points)


PLAN - VIEW


(Show a minimum of three reference ties to durable physical objects, relevant monuments and physical conditions that will enable recovery of the corner.)

NE CORNER
NW.1/4 SW.1/4
SEC. 21-76-26
Set C.I.R. #6808

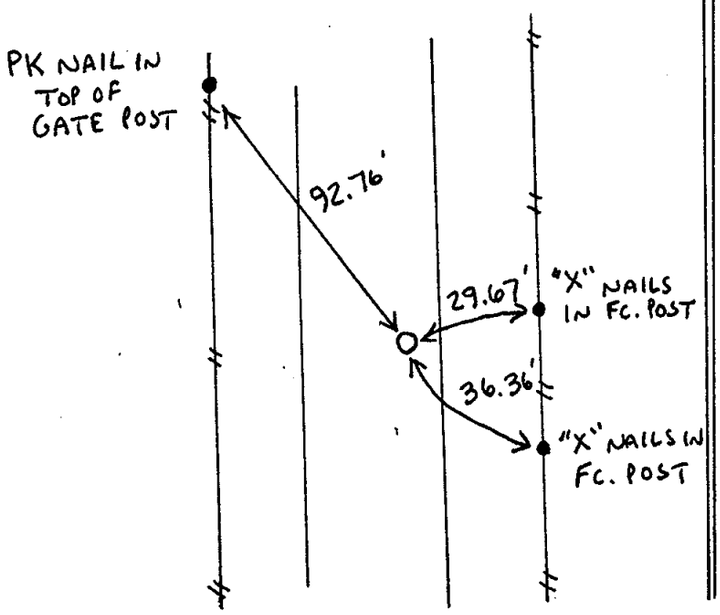

SE CORNER
NW.1/4 SW.1/4
SEC. 21-76-26
Set C.I.R. #6808

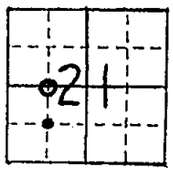

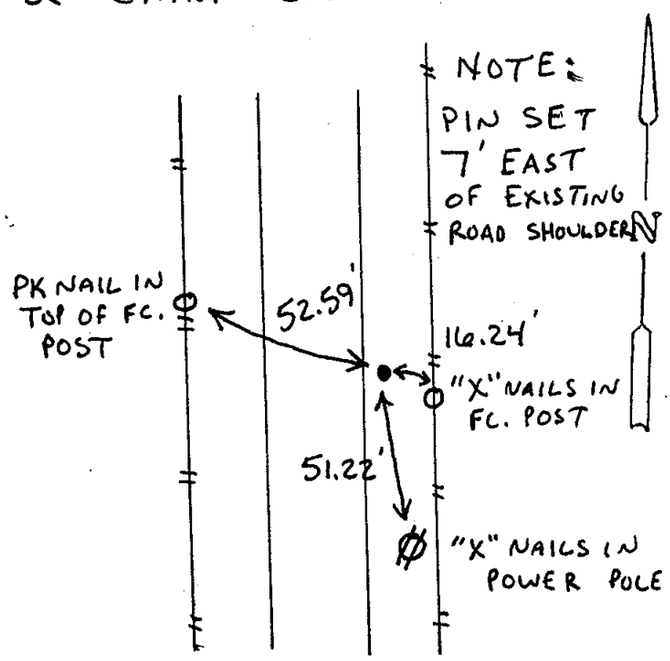

LICENSED LAND SURVEYOR
J. M. HOCHSTETLER
6808
IOWA

I hereby certify that this land surveying document was prepared and the related survey work was performed by me or under my direct personal supervision and that I am a duly licensed Land Surveyor under the laws of the State of Iowa.

J.M. HOCHSTETLER
License number 6808 Date 12/17/02
My license renewal date is December 31, 2003
Pages or sheets covered by this seal: 1

List Corners to be Indexed

Corners	Section	Twp	Range
NE cor. NW.1/4 SW.1/4	21	76N	26W
SE cor. NW.1/4 SW.1/4	21	76N	26W