000660

FILED NO. _____
BOOK 2003 PAGE 660
2003 FEB -5 PM 3:28

REC $ 5.00
AUD $ 1.00
R.M.F. $ 1.00

COMPUTER ✓
RECORDED ✓
COMPARED ✓

MICKI UTSLER
RECORDER
MADISON COUNTY, IOWA

VANCE & HOCHSTETLER, P.C., CONSULTING ENGINEERS, WINTERSET, IOWA (515) 462-3995
02-272S CHARLES T. VANCE, 110 West Green St., Winterset, Iowa, 50273
JAMES M HOCHSTETLER, 110 West Green St., Winterset, Iowa 50273

UNITED STATES PUBLIC LAND SURVEY CORNER CERTIFICATE OF

Land Survey Monuments situated in Section 2, Township 75 NORTH, Range 28 WEST, of the Fifth Principal Meridian, MADISON County, Iowa.
Previously recorded in _____ in County Recorder's Office.
(book, page, document number, etc.)

(Show reason for preparing this certificate, the evidence and detailed procedures used in establishing the the corner positions and monumentation found or placed.)


Monument Description and Remarks:

Center - Set Capped Iron Rod #6808 (½" rebar, 2" deep) at intersection of line from S.¼ cor to N.¼ cor. and side road centerline (also used R.O.W. stationing to find proper North position).

SW cor. NW.¼ SE.¼ - Set C.I.R. #6808 (½" rebar, exposed) in line with property line Fences between Center and S.¼ corner.

PLAN - VIEW

(Show a minimum of three reference ties to durable physical objects, relevant monuments and physical conditions that will enable recovery of the corner.)

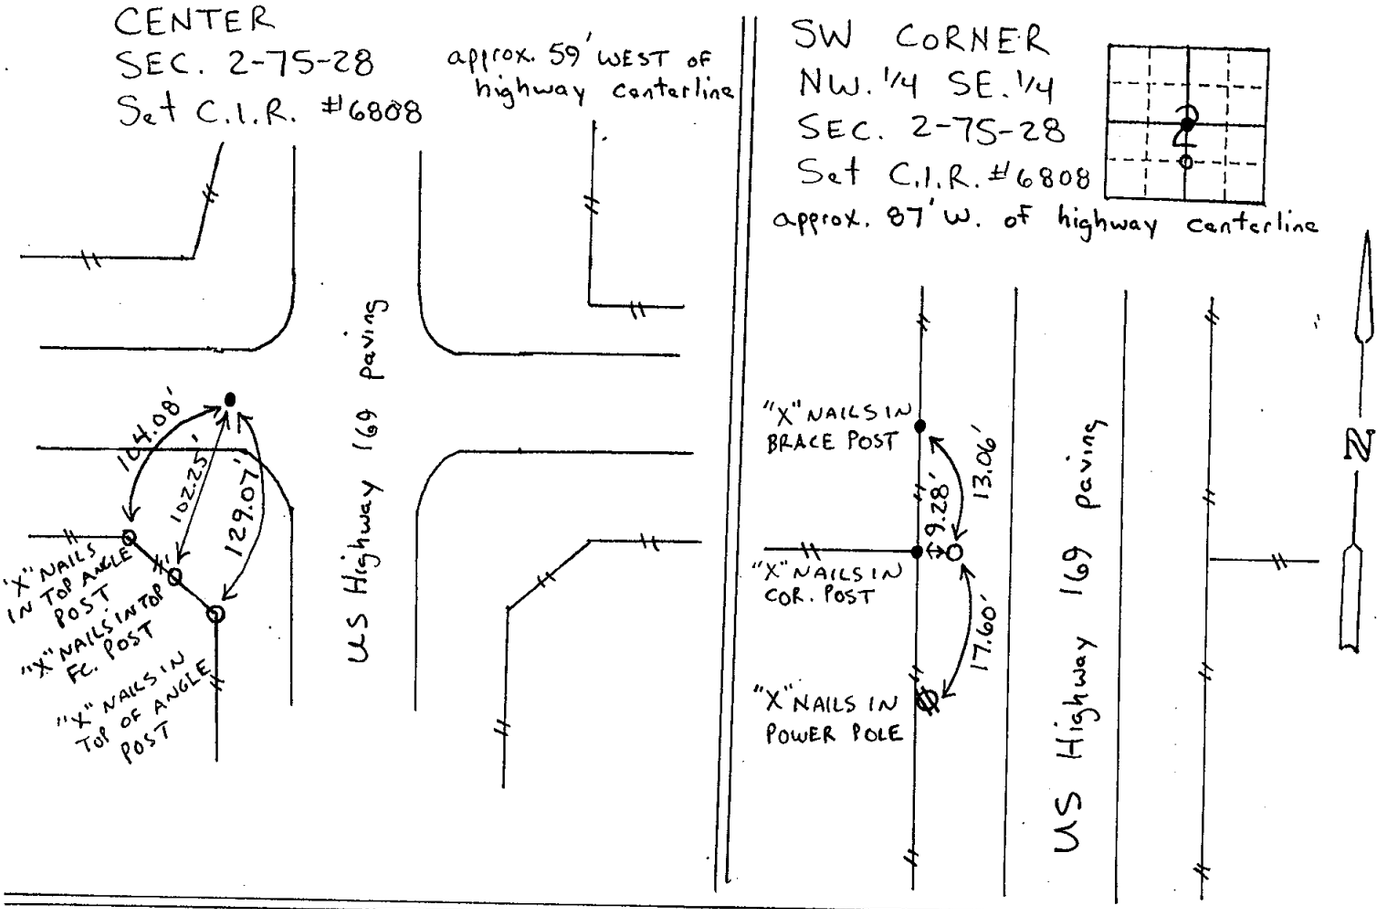

LICENSED LAND SURVEYOR
J. M. HOCHSTETLER
6808
IOWA

I hereby certify that this land surveying document was prepared and the related survey work was performed by me or under my direct personal supervision and that I am a duly licensed Land Surveyor under the laws of the State of Iowa.

J.M. Hochstetler

J.M. HOCHSTETLER
License number 6808 Date 1/20/03
My license renewal date is December 31, 2003
Pages or sheets covered by this seal: 1

List Corners to be Indexed

Corners	Section	Twp	Range
Center	2	75N	28W
SW cor. NW.¼ SE.¼	2	75N	28W