FILED NO.

800K2003 PAGE_ 832

000832

2003 FEB 14 PM 1:40


COMPUTER RECORDED COMPARED

MICKI UTSLER RECORDER MADISON COUNTY, I AWOI

VANCE & HOCHSTETLER, P.C. CONSULTING ENGINEERS, WINTERSE CHARLES T. VANCE, 110 WEST GREEN ST., WINTERSET, IOWA 5027 JAMES M HOCHSTETLER, 110 WEST GREEN ST., WINTERSET, IOWA WINTERSET, IOWA (515)462-3995 50273

REC \$
AUD \$

R.M.F. \$

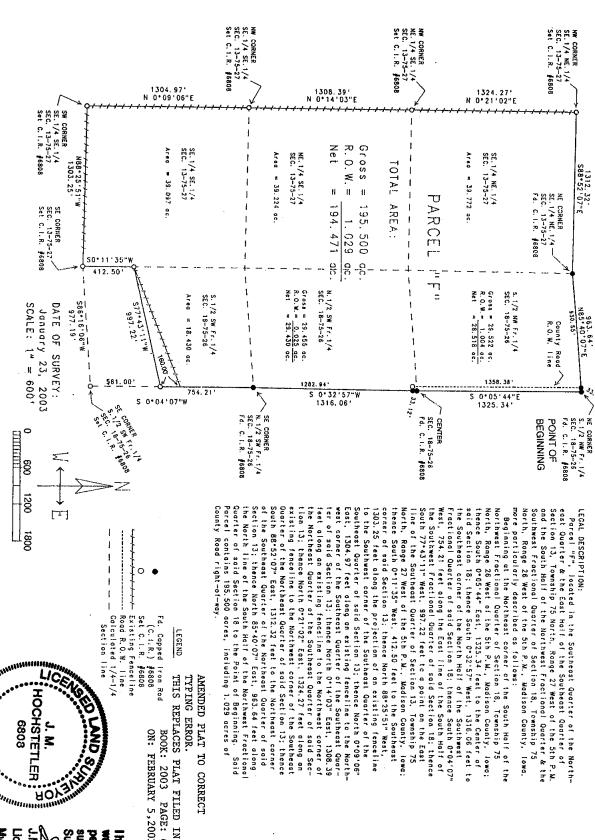

FRACTIONAL QUARTER OF SECTION 18, TOWNSHIP 75 NORTH, RANGE HALF OF THE NORTHWEST FRACTIONAL QUARTER & THE SOUTHWEST

26 WEST OF THE 5th P.M., MADISON COUNTY, IOWA.

EAST HALF OF THE SOUTHEAST QUARTER OF SECTION 13, TOWNSHIP

TED IN THE SOUTHEAST QUARTER OF THE NORTHEAST QUARTER & THE

& DEBORAH I.

BORGEN, LOCA-

PLAT OF SURVEY FOR JOSEPH A.

AMENDED

75 NORTH, TRANGE 27 WEST OF THE 5th P.M., AND IN THE SOUTH

LEGAL DESCRIPTION:
Parcel "F", located in the Southeast Quarter of the North-east Quarter & the Cast Holf of the Southeast Quarter of Section 13, Township 75 North, Range 27 West of the 5th P.M.

ON: FEBRUARY 5,2003 BOOK: 2003 PAGE: 663

Pages or sheets covered by this seal: J.M. HOCHSTETLER I hereby certify that this land surveying document was prepared and the related survey work was performed by me or under my direct personal My license renewal date is December 31, 2073 License number 6808 Date 2/13/03 Surveyor under the laws of the State of lowa. supervision and that I am a duly licensed Land J.m. Dakate