REC $ 5.00
AUD $
R.M.F. $ 1.00

FILED NO. 001902
BOOK 2003 PAGE 1902
2003 APR -3 AM 11:04
MICKI UTSLER
RECORDER
MADISON COUNTY, IOWA

COMPUTER ✓
RECORDED ✓
COMPARED

VANCE & HOCHSTETLER, P.C., CONSULTING ENGINEERS, WINTERSET, IOWA (515) 462-3995
03-195 CHARLES T. VANCE, 110 West Green St., Winterset, Iowa, 50273
JAMES M HOCHSTETLER, 110 West Green St., Winterset, Iowa 50273

UNITED STATES PUBLIC LAND SURVEY CORNER CERTIFICATE

OF

Land Survey Monuments situated in Section 27, Township 75 North, Range 27 West, of the Fifth Principal Meridian, MADISON County, Iowa.
Previously recorded in _____ in County Recorder's Office.
(book, page, document number, etc.)

(Show reason for preparing this certificate, the evidence and detailed procedures used in establishing the the corner positions and monumentation found or placed.)

Monument Description and Remarks:


Center - Fd. 1" square bar (3" deep) in roadway.

NE cor. NW.1/4 SW.1/4 - Set Capped Iron Rod #6808 (1/2" rebar, 2" deep) at midpoint between center and West 1/4 corner (both found points).


PLAN - VIEW

(Show a minimum of three reference ties to durable physical objects, relevant monuments and physical conditions that will enable recovery of the corner.)

CENTER
SEC. 27-75-27
Fd. 1" square bar

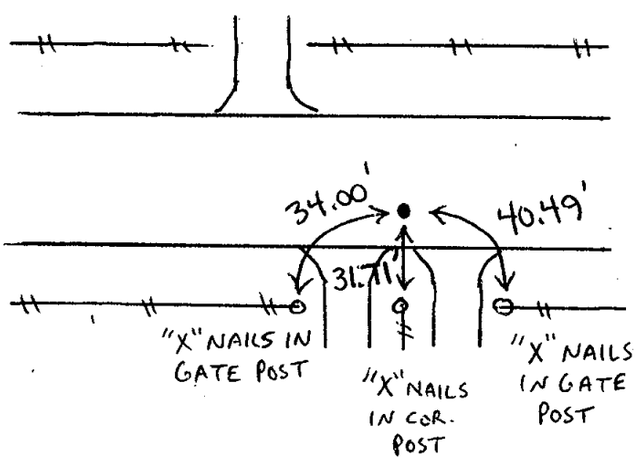

NE CORNER
NW.1/4 SW.1/4
SEC. 27-75-27
Set C.I.R. #6808

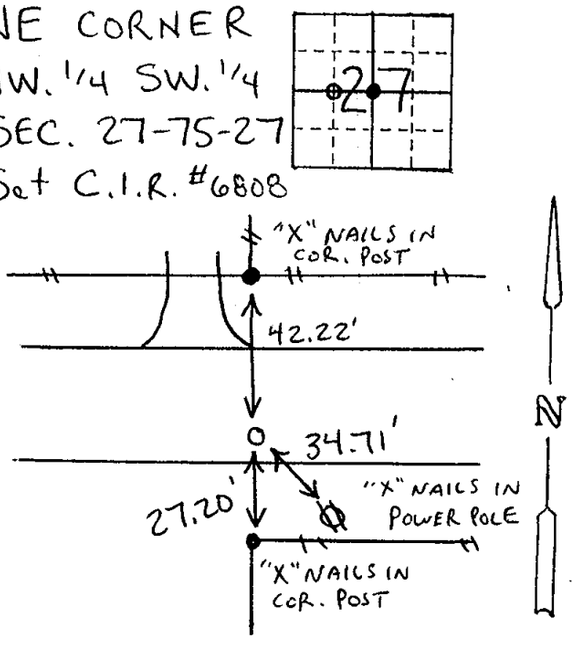



I hereby certify that this land surveying document was prepared and the related survey work was performed by me or under my direct personal supervision and that I am a duly licensed Land Surveyor under the laws of the State of Iowa.

J.M. Hochstetler

J.M. HOCHSTETLER
License number 6808 Date 3/20/03
My license renewal date is December 31, 2003
Pages or sheets covered by this seal: 1

List Corners to be Indexed

Corners	Section	Twp	Range
Center	27	75N	27W
NE cor NW.1/4 SW.1/4	27	75N	27W