REC $ 5.00
AUD $
R.M.F. $ 1.00

COMPUTER ✓
RECORDED ✓
COMPARED

FILED NO. 3668
BOOK 2003 PAGE 3668
2003 JUN 24 PM 3:27
MICKI UTSLER
RECORDER
MADISON COUNTY, IOWA

VANCE & HOCHSTETLER, P.C., CONSULTING ENGINEERS, WINTERSET, IOWA (515) 462-3995
03-67S CHARLES T. VANCE, 110 West Green St., Winterset, Iowa, 50273
JAMES M HOCHSTETLER, 110 West Green St., Winterset, Iowa 50273

UNITED STATES PUBLIC LAND SURVEY CORNER CERTIFICATE OF

Land Survey Monuments situated in Section 24, Township 77N, Range 27W, of the Fifth Principal Meridian, MADISON County, Iowa.
Previously recorded in _____ in County Recorder's Office.
(book, page, document number, etc.)


(Show reason for preparing this certificate, the evidence and detailed procedures used in establishing the the corner positions and monumentation found or placed.)

Monument Description and Remarks: SW COR NW¼ SE¼ - Set yellow CIR #6808 by projecting found corners at the N¼ Cor. and SW Cor NW¼ NE¼ to midpoint distance between N¼ Cor & found S¼ Cor which established calculated center of Section; Then Set SW Cor NW¼ SE¼ at midpoint on line between calculated Center & found S¼ Cor.

SE Cor. NW¼ SE¼ - Set yellow CIR #6808 by calculating the SE Cor NE¼ SE¼ based on found SE Cor and apparent E¼ Cor then set SE COR. NW¼ SE¼ at midpoint on line between Set SW COR NW¼ SE¼ and calculated SE Cor NE¼ SE¼

PLAN - VIEW

(Show a minimum of three reference ties to durable physical objects, relevant monuments and physical conditions that will enable recovery of the corner.)

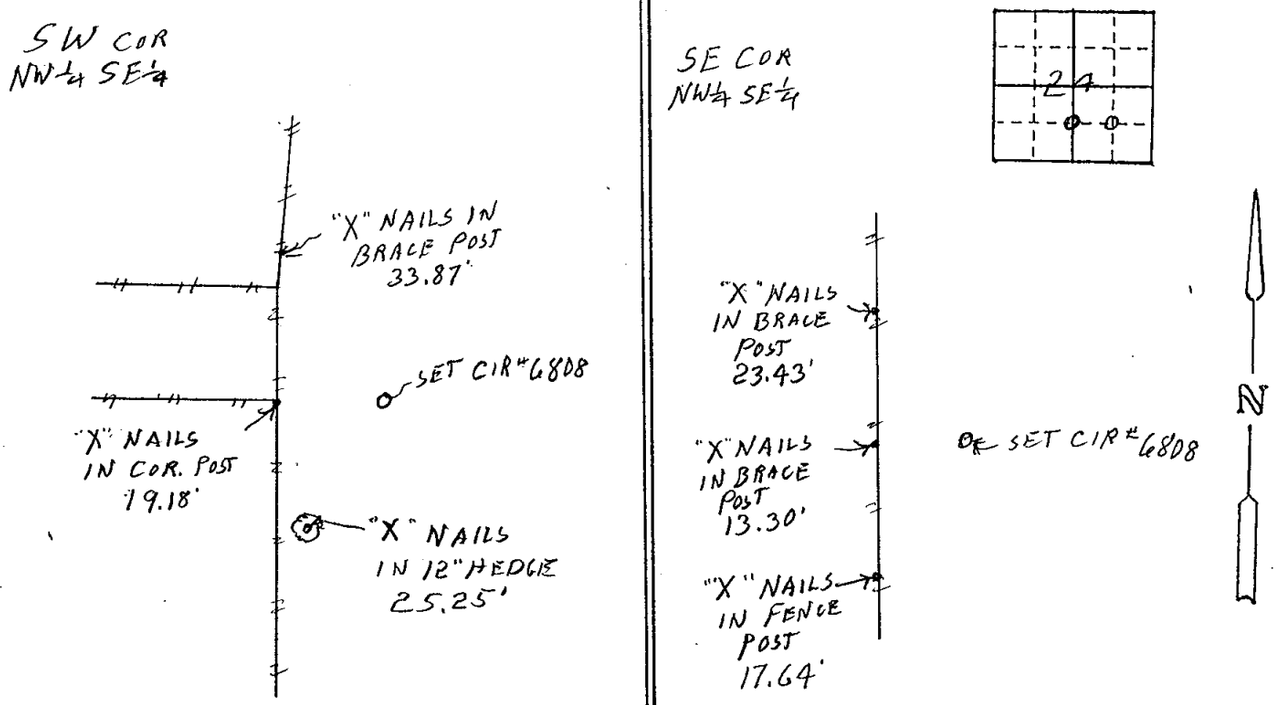

LICENSED LAND SURVEYOR
J. M. HOCHSTETLER
6808
IOWA

I hereby certify that this land surveying document was prepared and the related survey work was performed by me or under my direct personal supervision and that I am a duly licensed Land Surveyor under the laws of the State of Iowa.

J.M. Hochstetler
J.M. HOCHSTETLER
License number 6808 Date 6/24/03
My license renewal date is December 31, 2003
Pages or sheets covered by this seal: 1

List Corners to be Indexed

Corners	Section	Twp	Range
SW COR. NW¼ SE¼	24	77N	27W
SE COR. NW¼ SE¼	24	77N	27W