REC $ 5.00
AUD $ 1.00
R.M.F. $ 1.00
5.00

COMPUTER ✓
RECORDED ✓
COMPARED

FILED NO. 4788
BOOK 2003 PAGE 4788
2003 AUG 13 AM 11:33
MICKI UTSLER
RECORDER
MADISON COUNTY, IOWA

VANCE & HOCHSTETLER, P.C., CONSULTING ENGINEERS, WINTERSET, IOWA (515) 462-3995
03-22s CHARLES T. VANCE, 110 West Green St., Winterset, Iowa, 50273
JAMES M HOCHSTETLER, 110 West Green St., Winterset, Iowa 50273

# UNITED STATES PUBLIC LAND SURVEY CORNER CERTIFICATE

OF


Land Survey Monuments situated in Section 11, Township 76 N., Range 29 W, of the Fifth Principal Meridian, MADISON County, Iowa.
Previously recorded in _____ in County Recorder's Office.
(book, page, document number, etc.)


(Show reason for preparing this certificate, the evidence and detailed procedures used in establishihg the the corner positions and monumentation found or placed.)

Monument Description and Remarks: NW COR. NE¼ NW¼ - Set yellow CIR #6808 4" deep based on property line fence to West and centerline of vacated county road to the East.
SW Cor SE¼ NW¼ - Set yellow CIR #6808 4" deep at mid point between Set NW Cor. NE¼ NW¼ and ℄ County Road ROW at SW Cor SE¼ SW¼. Used ℄ County Road right-of-way for East/West location.

## PLAN - VIEW

(Show a minimum of three reference ties to durable physical objects, relevant monuments and physical conditions that will enable recovery of the corner.)

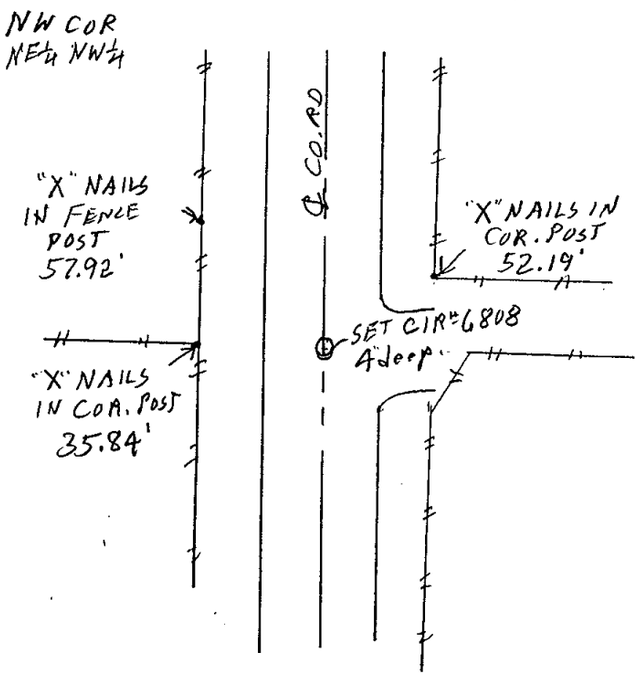

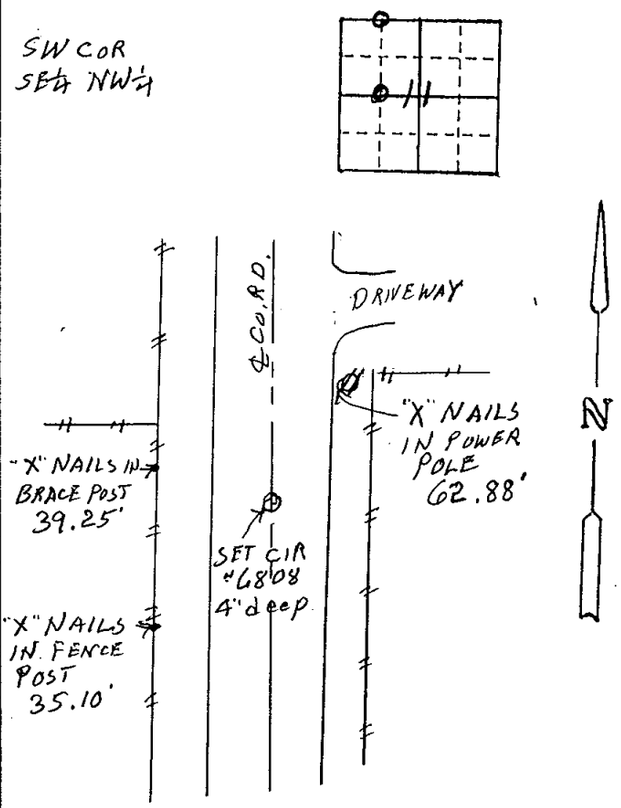
LICENSED LAND SURVEYOR
J. M. HOCHSTETLER
6808
IOWA

I hereby certify that this land surveying document was prepared and the related survey work was performed by me or under my direct personal supervision and that I am a duly licensed Land Surveyor under the laws of the State of Iowa.

J.M. HOCHSTETLER
License number 6808 Date 7/25/03.
My license renewal date is December 31, 2003
Pages or sheets covered by this seal: 1

List Corners to be Indexed

| Corners | Section | Twp | Range |
|---|---|---|---|
| NW COR NE¼ NW¼ | 11 | 76N | 29W |
| SW COR SE¼ NW¼ | 11 | 76N | 29W |