REC $ 5.00
AUD $ ____
R.M.F. $ 1.00
5.00

COMPUTER ✓
RECORDED ✓
COMPARED ____

FILED NO. 4790
BOOK 2003 PAGE 4790
2003 AUG 13 AM 11:35
MICKI UTSLER
RECORDER
MADISON COUNTY, IOWA

VANCE & HOCHSTETLER, P.C., CONSULTING ENGINEERS, WINTERSET, IOWA (515) 462-3995
03-143S CHARLES T. VANCE, 110 West Green St., Winterset, Iowa, 50273
JAMES M HOCHSTETLER, 110 West Green St., Winterset, Iowa 50273

UNITED STATES PUBLIC LAND SURVEY CORNER CERTIFICATE OF


Land Survey Monuments situated in Section 18, Township 76 N, Range 26 W, of the Fifth Principal Meridian, MADISON County, Iowa.
Previously recorded in _____ in County Recorder's Office.
(book, page, document number, etc.)


(Show reason for preparing this certificate, the evidence and detailed procedures used in establishing the the corner positions and monumentation found or placed.)


Monument Description and Remarks: SE COR NE¼SE¼ - Found CIR # 5041 6" deep Set for Subd. in Section 17 in 1977. E¼ Cor - Set yellow CIR #6808 4" deep based on projection of line from found CIR #5041 at SE Cor through found CIR #5041 at SE Cor NE¼SE¼ to existing P/L fence from West. NW COR NE¼SE¼ - Set yellow CIR #6808 at 1320' along existing P/L fence from Set E¼ Cor. SW COR NE¼SE¼ - Set yellow CIR #6808 on line between found CIR #5041 at SW COR SE¼SE¼ & Set CIR #6808 at NW COR NE¼SE¼ in line with P/L fence East.


PLAN - VIEW

(Show a minimum of three reference ties to durable physical objects, relevant monuments and physical conditions that will enable recovery of the corner.)

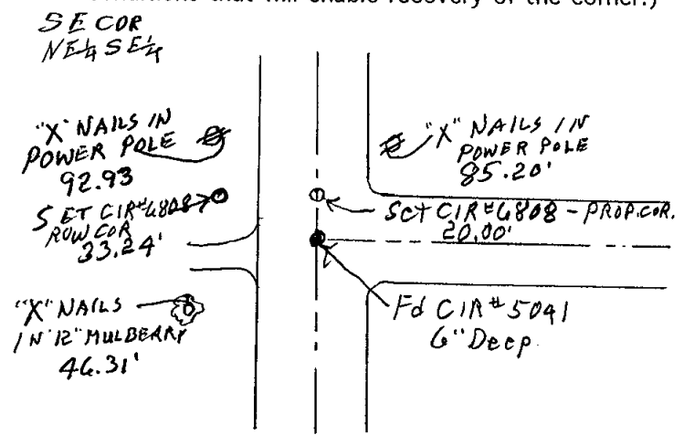

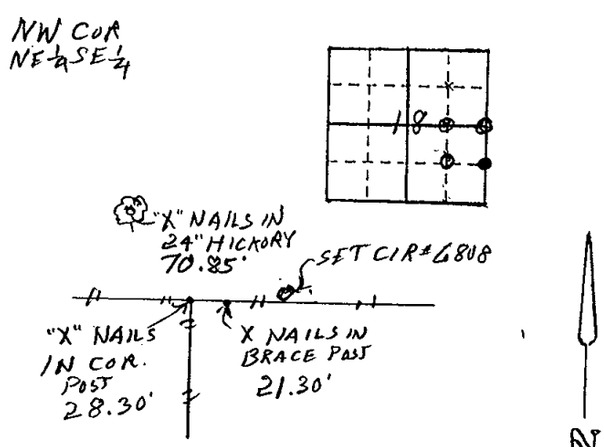

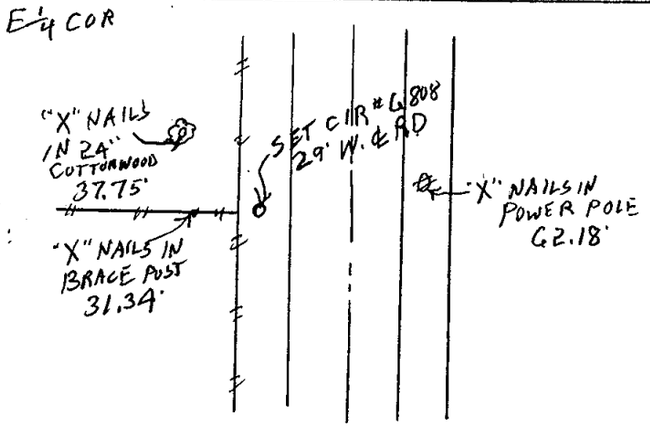

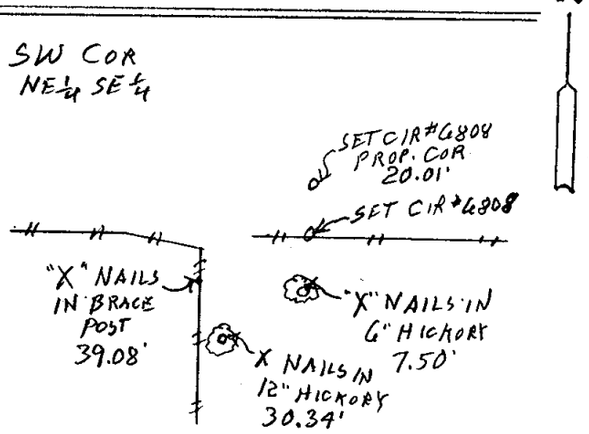

LICENSED LAND SURVEYOR
J. M. HOCHSTETLER
6808
IOWA

I hereby certify that this land surveying document was prepared and the related survey work was performed by me or under my direct personal supervision and that I am a duly licensed Land Surveyor under the laws of the State of Iowa.

J.M. Hochstetler
J.M. HOCHSTETLER
License number 6808 Date 8/6/03.
My license renewal date is December 31, 2003
Pages or sheets covered by this seal: 1

List Corners to be Indexed

Corners	Section	Twp	Range
SE COR NE¼SE¼	18	76N	26W
E¼ COR	18	76N	26W
NW COR NE¼SE¼	18	76N	26W
SW COR.	18	76N	26W