FILED NO. 5555
BOOK 2003 PAGE 5555
2003 SEP 17 AM 8: 13
MICKI UTSLER
RECORDER
MADISON COUNTY, IOWA

REC $ 5.00
AUD $
R.M.F. $ 1.00
5.00

COMPUTER ✓
RECORDED
COMPARED

VANCE & HOCHSTETLER, P.C., CONSULTING ENGINEERS, WINTERSET, IOWA (515) 462-3995
03-1605 CHARLES T. VANCE, 110 West Green St., Winterset, Iowa, 50273
JAMES M HOCHSTETLER, 110 West Green St., Winterset, Iowa 50273

UNITED STATES PUBLIC LAND SURVEY CORNER CERTIFICATE

OF

Land Survey Monuments situated in Section 34, Township 77 N, Range 26 W, of the Fifth Principal Meridian, MADISON County, Iowa.
Previously recorded in _____ in County Recorder's Office.
(book, page, document number, etc.)

(Show reason for preparing this certificate, the evidence and detailed procedures used in establishing the the corner positions and monumentation found or placed.)


Monument Description and Remarks: N¼ Cor. - Set yellow CIR #6808 4" deep in line with old property line fence to West and on line between center of Section 27 and center of Section 34. Could not find nail tied by Vance in Feb 1995.

SE COR NE¼ NW¼ - Set yellow CIR #6808 at midpoint on line between found center & set N¼ Cor

SW Cor. NW¼ NW¼ - Set yellow CIR #6808 in line with old property line fence to East at ℄ County Road.

PLAN - VIEW

(Show a minimum of three reference ties to durable physical objects, relevant monuments and physical conditions that will enable recovery of the corner.)

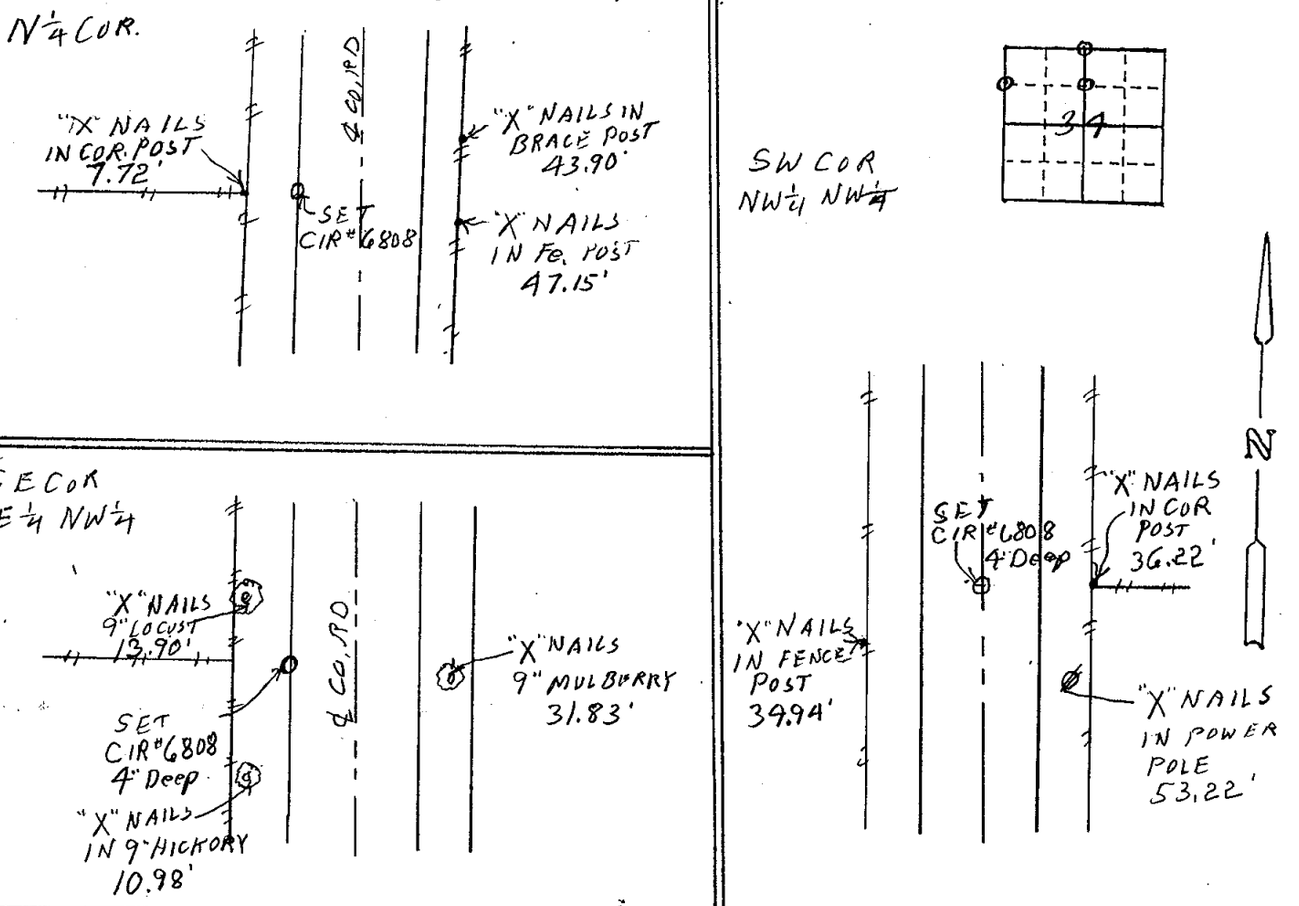

LICENSED LAND SURVEYOR
J. M. HOCHSTETLER
6808
IOWA

I hereby certify that this land surveying document was prepared and the related survey work was performed by me or under my direct personal supervision and that I am a duly licensed Land Surveyor under the laws of the State of Iowa.

J.M. Hochstetler

J.M. HOCHSTETLER
License number 6808 Date 9/4/03
My license renewal date is December 31, 2003
Pages or sheets covered by this seal: 1

List Corners to be Indexed

Corners	Section	Twp	Range
N¼ Cor	34	77N	26W
SE COR NE¼ NW¼	34	77N	26W
SW COR NW¼ NW¼	34	77N	26W