REC $ 5.00
AUD $
R.M.F. $ 1.00
5.00

COMPUTER ✓
RECORDED ✓
COMPARED

FILED NO. 6245
BOOK 2003 PAGE 6245
2003 OCT 16 PM 3:19
MICKI UTSLER
RECORDER
MADISON COUNTY, IOWA

✓RETURN TO : BOLDMAN LAND SURVEYING, P.C., BOX 66, WINTERSET,IA 50273 515-462-9242

UNITED STATES PUBLIC LAND SURVEY CORNER CERTIFICATE OF


Land Survey Monuments situated in Section 17, Township 76 N, Range 29 W, of the Fifth Principal Meridian, MADISON County, Iowa
Previously recorded in NONE FOUND In County Recorder's Office.
(book, page, document number, etc.)

(show reason for preparing this certificate, the evidence and detailed procedures used in establishing the corner positions and monumentation found or placed.)

Monument Description and Remarks: ① Set pin @ R.O.W. split in line w/ N-S fence. Nearly splits ½ mile. ② Set pin at corner post. Used pk as ref. pts.

PLAN VIEW

(Show a minimum of three reference ties to durable physical objects, relevant monuments and physical conditions that will enable recovery of the corner.)

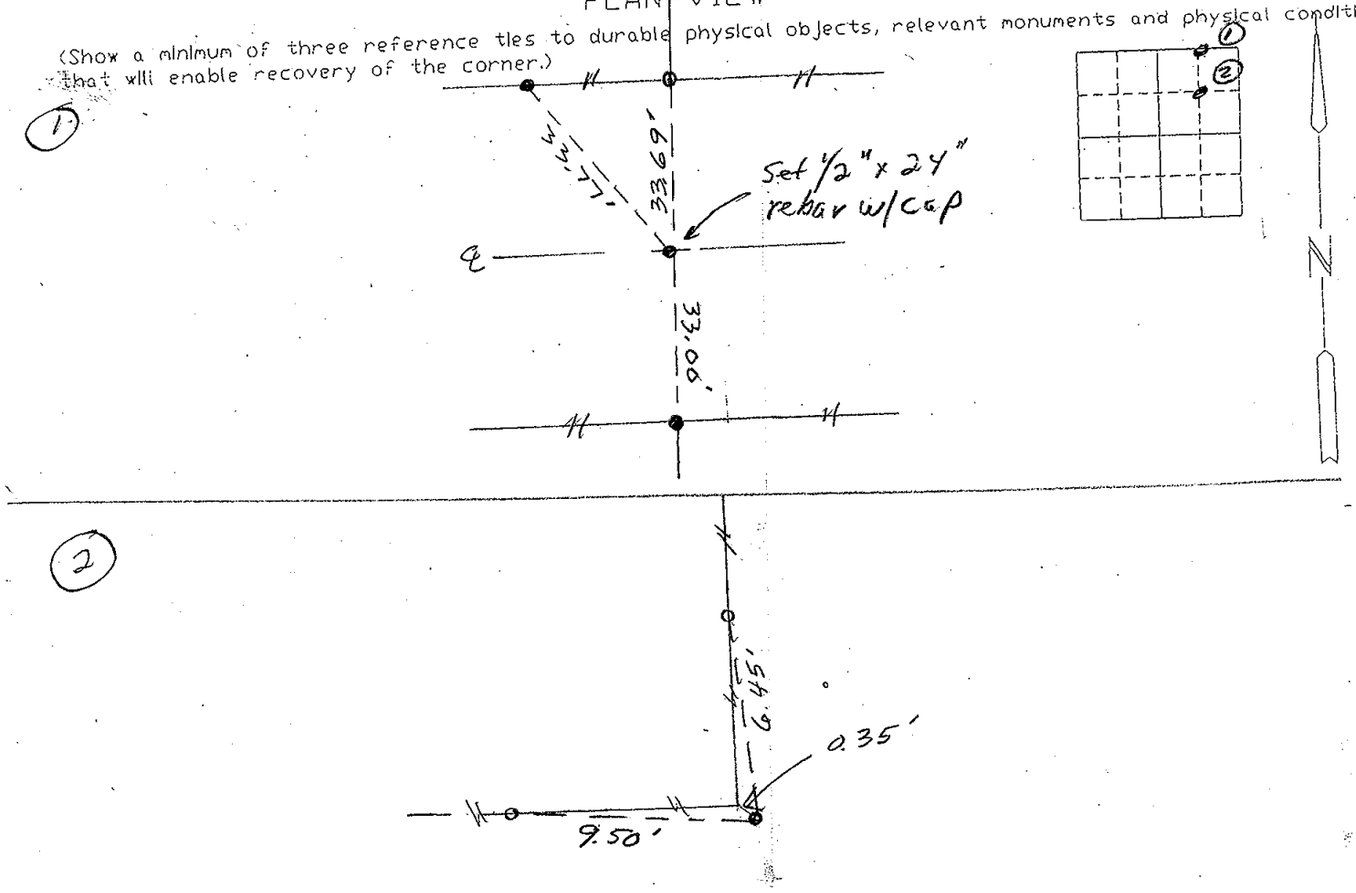

I hereby certify that the survey work was completed and this certificate was prepared by me or under my direct personal supervision and that I am a duly Licensed Land Surveyor under the laws of the State of Iowa

Signature: Craig S. Boldman
Craig S. Boldman

Date: 10/16/03 Reg. No. 13427

SEAL

LICENSED LAND SURVEYOR
CRAIG S. BOLDMAN
13427
IOWA

List Corners to be Indexed

Corners	Section	Twp	Range
NW Cor NE¼ NE¼	17	76	29
SW COR NE¼ NE¼	"	"	"