


REC \$ 5.00
AUD \$
R.M.F. \$ 5.00

COMPUTER
RECORDED
COMPARED


MICKI UTSLER
RECORDER
MADISON COUNTY, IOWA

Prepared by: Boldman Land Surveying, L.L.C., P.O. Box 66, Winterset, Ia. 50273. (515)462-9242


RETRACEMENT SURVEY OF LOTS 102, 103, AND 104 OF BLOCK 2 IN
MACK'S ADDITION TO THE TOWN OF MACKSBURG, MADISON COUNTY, IOWA.

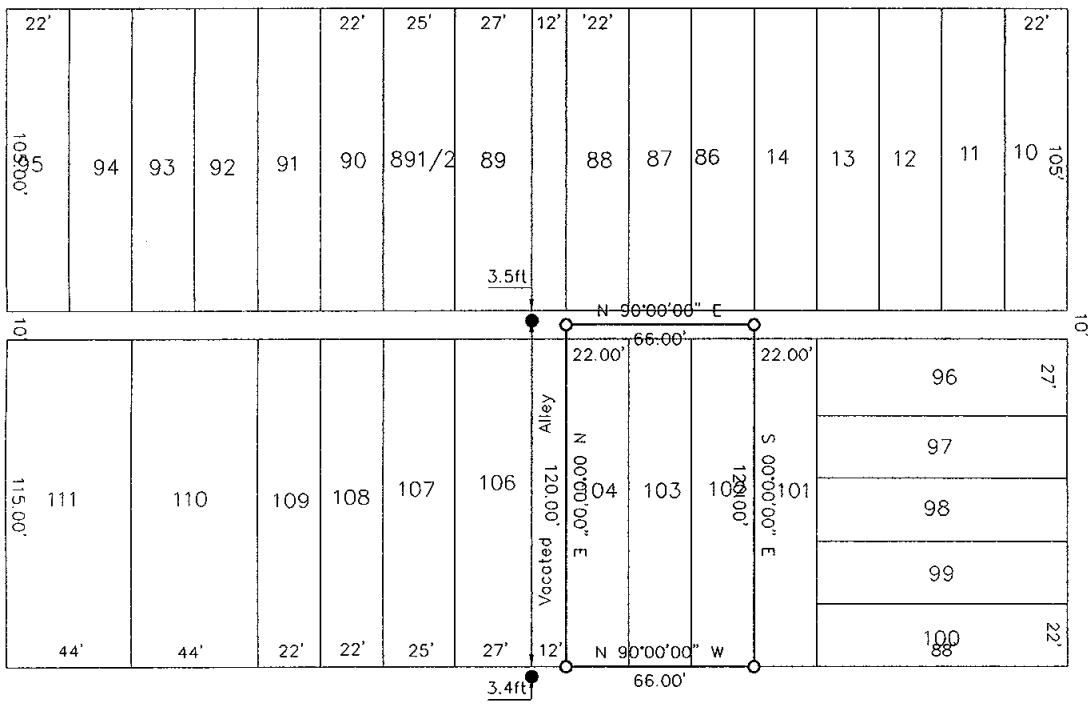

CHURCH STREET (56' R/W)

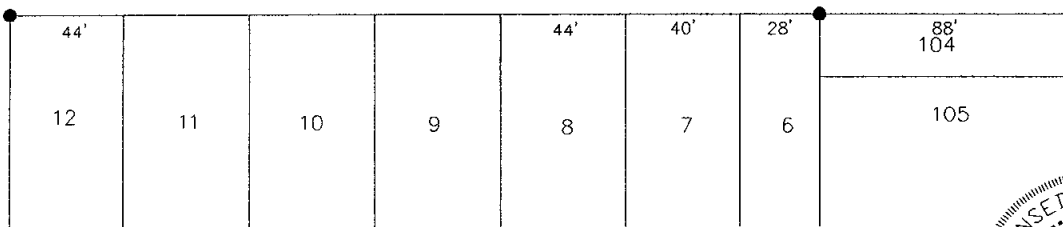

- SET 1/2"X24"REB.CAP L.S. 13427
- IRON PIN FOUND

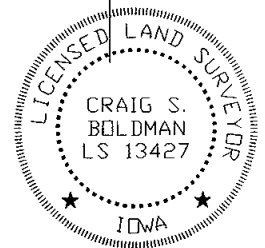

I HEREBY CERTIFY THAT THIS LAND SURVEYING DOCUMENT WAS PREPARED AND THE RELATED SURVEY WORK WAS PERFORMED BY ME OR UNDER MY DIRECT PERSONAL SUPERVISION AND THAT I AM A DULY LICENSED LAND SURVEYOR UNDER THE LAWS OF THE STATE OF IOWA.

SIGNATURE: *Craig S. Boldman*
NAME: CRAIG S. BOLDMAN
DATE: 10/18/03
MY LICENSE RENEWAL DATE IS: DECEMBER 31, 2004

REQUESTED BY: Chris Randol		BOLDMAN LAND SURVEYING, L.L.C. P.O. BOX 66 WINTERSSET, IA. 50273 (515)462-9242
SURVEYED 9/18/03	SCALE 1"=50'	
PROJECT NO. 03082	DATE	OWNER Chris Randol