REC $ 5.00
AUD $
R.M.F. $ 1.00
5.00

COMPUTER ✓
RECORDED ✓
COMPARED

FILED NO. 6551
BOOK 2003 PAGE 6551
2003 OCT 30 PM 2:13
MICKI UTSLER
RECORDER
MADISON COUNTY, IOWA

✓ VANCE & HOCHSTETLER, P.C., CONSULTING ENGINEERS, WINTERSET, IOWA (515) 462-3995
03-157s CHARLES T. VANCE, 110 West Green St., Winterset, Iowa, 50273
JAMES M HOCHSTETLER, 110 West Green St., Winterset, Iowa 50273

UNITED STATES PUBLIC LAND SURVEY CORNER CERTIFICATE

OF

Land Survey Monuments situated in Section 25, Township 76N, Range 28W, of the Fifth Principal Meridian, MADISON County, Iowa.
Previously recorded in _____ in County Recorder's Office.
(book, page, document number, etc.)


(Show reason for preparing this certificate, the evidence and detailed procedures used in establishing the the corner positions and monumentation found or placed.)

Monument Description and Remarks: NW COR. SE¼ NW¼ - Set yellow CIR #6808 on line at midpoint between found NW Cor SW¼ NW¼ and NE Cor SE¼ NW¼.

SW COR SE¼ NW¼ - Set yellow CIR #6808 on line at midpoint between W¼ Cor and Center of Section.

PLAN - VIEW

(Show a minimum of three reference ties to durable physical objects, relevant monuments and physical conditions that will enable recovery of the corner.)

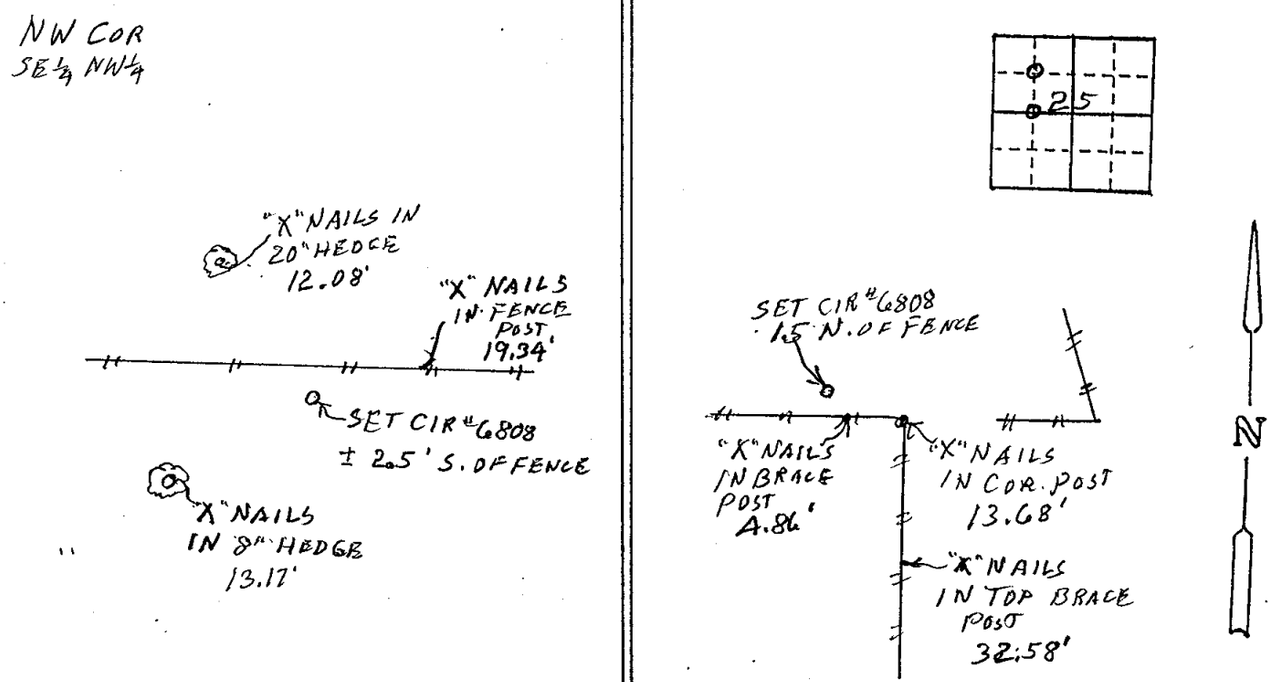

LICENSED LAND SURVEYOR
J. M. HOCHSTETLER
6808
IOWA

I hereby certify that this land surveying document was prepared and the related survey work was performed by me or under my direct personal supervision and that I am a duly licensed Land Surveyor under the laws of the State of Iowa.

J.M. HOCHSTETLER
License number 6808 Date 10/28/03.
My license renewal date is December 31, 2003
Pages or sheets covered by this seal: 1

List Corners to be Indexed

Corners	Section	Twp	Range
NW COR SE¼ NW¼	25	76N	28W
SW COR SE¼ NW¼	25	76N	28W