REC $ 5 00
AUD $
R.M.F. $ 1 00
5 00

FILED NO. 6810
BOOK 2003 PAGE 6810

COMPUTER ✓
RECORDED ✓
COMPARED

2003 NOV 13 PM 3:02

MICKI UTSLER
RECORDER
MADISON COUNTY, IOWA

VANCE & HOCHSTETLER, P.C., CONSULTING ENGINEERS, WINTERSET, IOWA (515) 462-3995
03-137S Seley
CHARLES T. VANCE, 110 West Green St., Winterset, Iowa, 50273
JAMES M HOCHSTETLER, 110 West Green St., Winterset, Iowa 50273

UNITED STATES PUBLIC LAND SURVEY CORNER CERTIFICATE

OF


Land Survey Monuments situated in Section 17, Township 74 N, Range 27 W, of the Fifth Principal Meridian, MADISON County, Iowa.
Previously recorded in _____ in County Recorder's Office.
(book, page, document number, etc.)


(Show reason for preparing this certificate, the evidence and detailed procedures used in establishing the the corner positions and monumentation found or placed.)

Monument Description and Remarks: S 1/4 Cor - Set yellow CIR #6808 on projection of line from found SE cor of Section through set Corner at SE Cor. SW1/4SE1/4 at intersection with projected line from N 1/4 Cor through found Center of Section.
SE Cor. SW1/4 SE1/4 - Set yellow CIR #6808 at old Corner post in East & West fence line.
NE COR NW1/4 SE1/4 - Set yellow CIR #6808 on line between found center of Section and E 1/4 Corner at 4-Way fence intersection.

PLAN - VIEW

(Show a minimum of three reference ties to durable physical objects, relevant monuments and physical conditions that will enable recovery of the corner.)

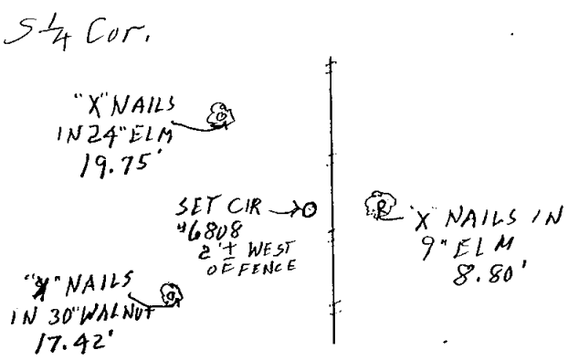

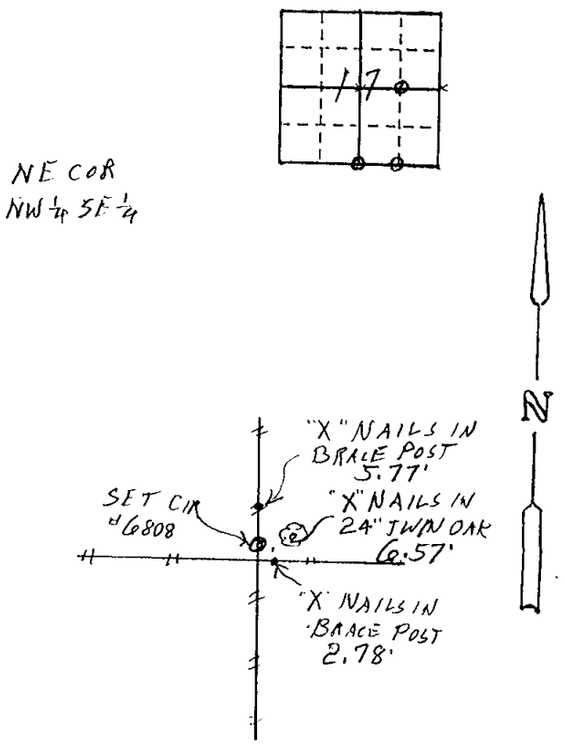

LICENSED LAND SURVEYOR
J. M. HOCHSTETLER
6808
IOWA

I hereby certify that this land surveying document was prepared and the related survey work was performed by me or under my direct personal supervision and that I am a duly licensed Land Surveyor under the laws of the State of Iowa.

J.M. HOCHSTETLER
License number 6808 Date 11/13/03.
My license renewal date is December 31, 2003
Pages or sheets covered by this seal: 1

List Corners to be Indexed

Corners	Section	Twp	Range
S 1/4 Cor.	17	74N	27W
SE COR. SW1/4 SE1/4	17	74N	27W
NE COR NW1/4 SE1/4	17	74N	27W